THIS PERMIT REPLACES ONE PREVIOUSLY ISSUED ON 2-12-99

IREDELL COUNTY HEALTH DEPARTMENT

STATESVILLE 704-878-5305 ✓ MOORESVILLE 704-664-5281

IMPROVEMENT PERMIT / AUTHORIZATION TO CONSTRUCT / OPERATION PERMIT / EXISTING SYSTEM INSPECTION

PERMIT# 079526 PIN# 4711316122 DATE 11-9-01

OWNER OR CONTRACTOR LAKE NORMAN PROPERTIES / LARRY McGOUGH PHONE: Business 1-800-420-6537 Home 1-440-985-2602 OHIO

ADDRESS 168 Westchester DR AMHERST OHIO 44001

LOCATION LAUREL COVE (E) HARBOR WATCH TAKE FIRST RIGHT, (D) HARBOR RIDGE, (B) HUNTCLIFF, (C) BARGATE AT END

SUBDIVISION HARBOR WATCH BLOCK / SECTION 6 LOT 146 LOT AREA 3.28 ACRE SITE CLASS PS DESIGN FLOW 480 L.T.A.R. .3

Septic Tank: 1000 Gallons: STB 760 Date 8-6-01
Pump Tank: _____ Gallons: PT _____ Date _____
Pump Make: _____ Model _____ Serial No. _____
Nitrification Field: No Fields 1 Square Feet EQ=1600 Linear Feet 400'
No Lines 5x80' Trench Width 36" Max Trench Bottom Depth 36" Gravel Depth N/A

☒ New System ☐ Repair System Type: I, II, (III) IV, V, VI
System Description: GRAV 2540 REDUCT
Repair System Description: SAME / PANEL
Maintenance Agreement Required: ☐ Yes ☒ No


☒ House/Mod. Home ☐ Mobile Home ☐ Business ☐ Other
No Bedrooms 4 No. Bathrooms 3 No. Employees ____
☐ Slab ☐ Crawl Space ☒ Basement w/plumbing ☐ Basement w/o plumbing

Water Supply: ☒ Individual ☒ Public ☐ Community WELL


Comments/Conditions: (D) INSTALL LINES ON CONTOURS (E) MAINTAIN SETBACKS (B) KEEP WELL 100' FROM ANY PART OF SYSTEM. (A) SIDE ENTRY GARAGE IS ALSO OK. (C)

Comments/Conditions: CHANGED STUB TO UPPER SIDE OF HOUSE WHEN FLAGGED OUT
- Zabel Filter Installed
- ST Riser Installed

INITIAL SITE SKETCH

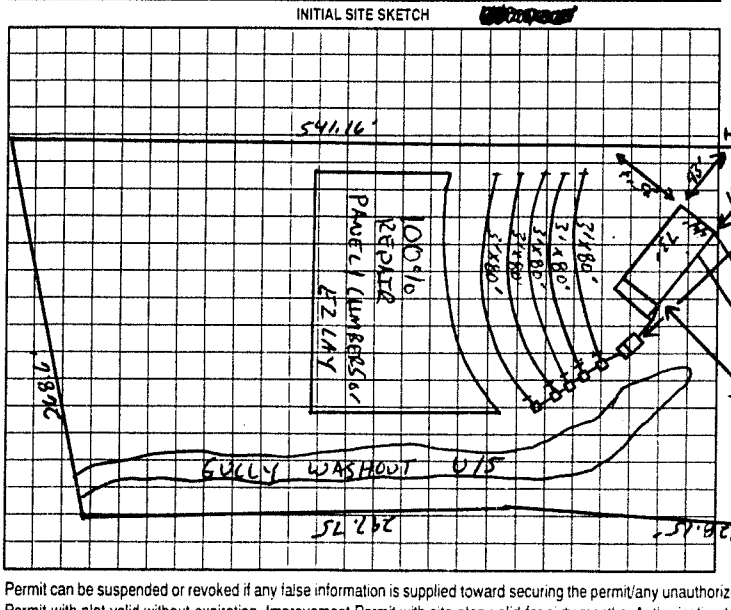

AS BUILT SKETCH

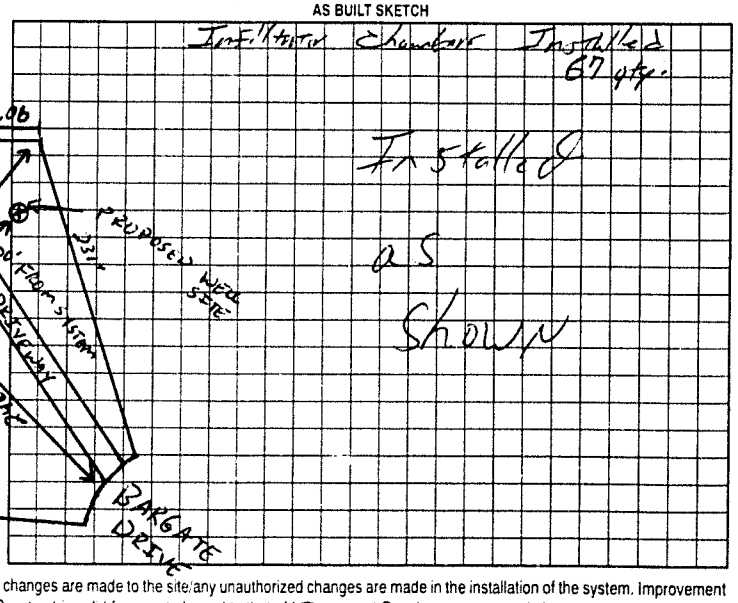

Permit can be suspended or revoked if any false information is supplied toward securing the permit/any unauthorized changes are made to the site/any unauthorized changes are made in the installation of the system. Improvement Permit with plat valid without expiration. Improvement Permit with site plan valid for sixty months. Authorization to Construct is valid for a period equal to that of Improvement Permit – not to exceed sixty months.

Signed: Larry McGough date 11-9-01
Improvement Permit by: Ron Cuske RS date 11-9-01
Authorization to Construct by: Ron Cuske RS date 11-9-01
Installed by: Barry Sigmon
Operation Permit by: William O. Johnson date 12/21/01
Existing System Inspection by: _____ date _____

HEALTH DEPT. COPY WHITE OWNER COPY (FINAL) YELLOW OWNER COPY (INITIAL) PINK