IREDELL COUNTY HEALTH DEPARTMENT

STATESVILLE 704-878-5305 MOORESVILLE 704-664-5281

IMPROVEMENT PERMIT / AUTHORIZATION TO CONSTRUCT / OPERATION PERMIT / EXISTING SYSTEM INSPECTION

PERMIT# 21737 PIN# 4711-22-2336 DATE 10-27-04

OWNER OR CONTRACTOR HERITAGE HOMES PHONE: Business 470-222-7370 Home

ADDRESS P.O. BOX 3333 MOORESVILLE, NC 28117

LOCATION BUFFALO SHOALS WEST (L) LAUREL COVE RD (R) HARBORWATCH (L) HARBORWATCH DR (L) HARBOR RIDGE (R) HUNTCLIFFE LOT #149 ON LEFT

SUBDIVISION HARBORWATCH BLOCK / SECTION VI LOT 149 LOT AREA 1.695AC SITE CLASS PS DESIGN FLOW 360 L.T.A.R. .5

Septic Tank: 1000 Gallons; STB 825 Date 2-22-06
Pump Tank: Gallons; PT Date
Pump Make: Model Serial No.
Nitrification Field: No Fields 1 Square Feet ED=1200 Linear Feet 300'
No Lines 3 Trench Width 36" Max Trench Bottom Depth 36" Gravel Depth N/A

[X] New System [ ] Repair System Type: I, II, III, IV, V, VI
System Description: 60% 25%/D REDUCT
Repair System Description: LP 50%/D REDUCT
Maintenance Agreement Required: [ ] Yes [X] No

[X] House/Mod. Home [ ] Mobile Home [ ] Business [ ] Other
No. Bedrooms 3 No. Bathrooms 2½ No. Employees


[ ] Slab [ ] Crawl Space [X] Basement w/plumbing [ ] Basement wo/plumbing

Water Supply: [X] Individual [ ] Public [ ] Community WELL

Comments/Conditions: (1) HOUSE IS STAKED & SYSTEM SHOT IN & FLAGGED (2) START BASEMENT CUT AT MINIMUM GRADE AT BALL OF HOUSE & DIG INTO THE HILL (3) MAINTAIN SETBACKS & INSTALL LINES ON CONTOURS

Comments/Conditions: X BUILDER AND I (LL) ACKNOWLEDGED LOT 149 PERMIT HAD EXPIRED. THAT ENABLED THE SEPTIC TO BE PLACED WHERE DRAWN.

INITIAL SITE SKETCH

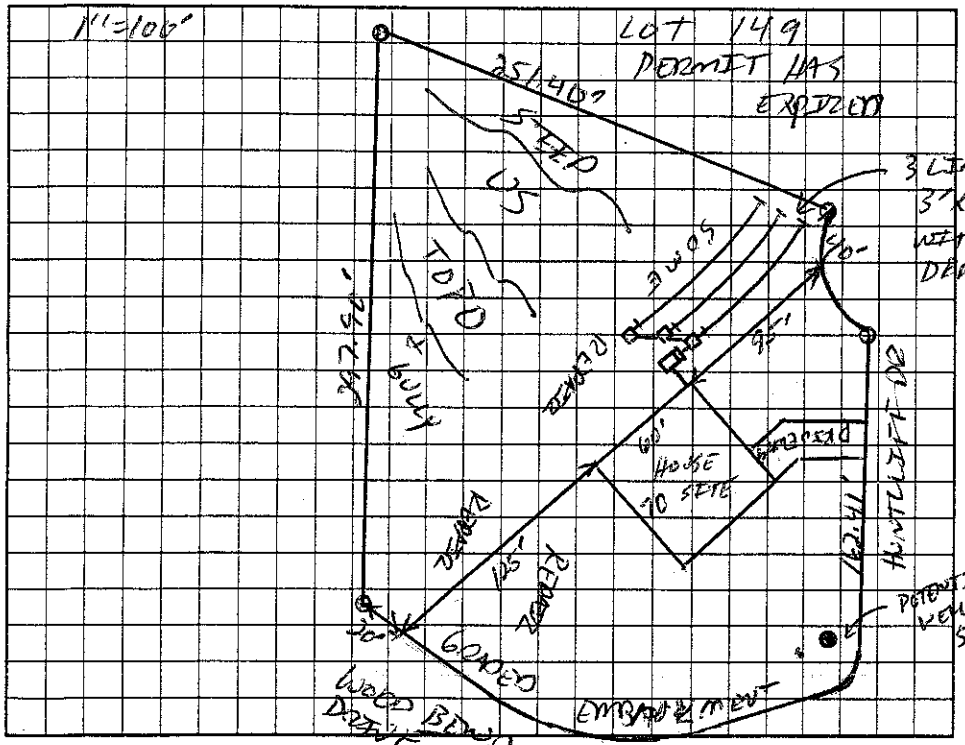

AS BUILT SKETCH

POLYFLOW F.H. & MARKER INSTALLED AS DRAWN

WELL IS 115' FROM TANK

X REMOVED 2-3' F.U & INSTALLED LINES IN NATURAL SOIL

Permit can be suspended or revoked if any false information is supplied toward securing the permit/any unauthorized changes are made to the site/any unauthorized changes are made in the installation of the system. Improvement Permit with plat valid without expiration. Improvement Permit with site plan valid for sixty months. Authorization to Construct is valid for a period equal to that of Improvement Permit – not to exceed sixty months.

Signed: WM Faulkner date 10-28-04 Installed by: JOE THOMPSON

Improvement Permit by: date 10-27-04 Operation Permit by: date 6-19-06

Authorization to Construct by: date 10-27-04 Existing System Inspection by: date

HEALTH DEPT. COPY: WHITE OWNER COPY (FINAL): YELLOW OWNER COPY (INITIAL): PINK