THIS PERMIT VOIDS PREVIOUS ISSUED 7-10-98

IREDELL COUNTY HEALTH DEPARTMENT

STATESVILLE 704-878-5305 MOORESVILLE 704-664-5281

IMPROVEMENT PERMIT / AUTHORIZATION TO CONSTRUCT / OPERATION PERMIT / EXISTING SYSTEM INSPECTION

PERMIT# 073304 PIN# 4711 22 5907 DATE 8-25-01

OWNER OR CONTRACTOR MIKE & SONYA LEONARD PHONE: Business (704) 662-8430 Home (704) 528-4980

ADDRESS 109 DAWNWOOD LANE, STATESVILLE, NC 28677-8488

LOCATION BUFFALO SHOALS RD, TL LAUREL COVE RD, TR HARBOR GATE, TR HARBOR WATCH, TL HARBOR RIDGE, 2ND (R) AT STONECREST

SUBDIVISION HARBOR WATCH BLOCK / SECTION IV LOT 154 LOT AREA 1.540 ACRES SITE CLASS PS DESIGN FLOW 480 L.T.A.R. 0.33 GPD/FT²

Septic Tank: 1000 Gallons; STB 1012 Date 4-21-01

Pump Tank: 1000 Gallons; PT 17 Date 7-28-00

Pump Make: HYDROMATIC Model SK60M1 Serial No.

Nitrification Field: No Fields 1 Square Feet REQ. 1440 Linear Feet 240

No Lines SIX Trench Width 24" Max Trench Bottom Depth 36"

☑ New System ☐ Repair System Type: I, II, (III), IV, V, VI

System Description: PPBPS, PUMP - FED

Repair System Description: PPBPS, LOW PRESSURE

Maintenance Agreement Required: ☐ Yes ☑ No

Gravel Depth SAND 6" ☐ Slab ☐ Crawl Space ☑ Basement w/plumbing ☐ Basement wo/plumbing

☑ House/Mod. Home ☐ Mobile Home ☐ Business ☐ Other


No. Bedrooms 4 No. Bathrooms 2½ No. Employees

Water Supply: ☑ Individual ☐ Public ☐ Community WELL


Comments/Conditions: ① INSTALL FIFTY-FOUR (54) PPBPS PANELS IN SIX EQUAL LENGTH LINES ② SEE ATTACHED SHEETS FOR PUMP & PRESSURE MANIFOLD REQUIREMENTS

Comments/Conditions: ① SEPTIC TANK WITH RISERS INSTALLED USING "POLY LOK" FILTER ② SYSTEM PRESSURE CHECKED 8-28-01, RSH.

INITIAL SITE SKETCH

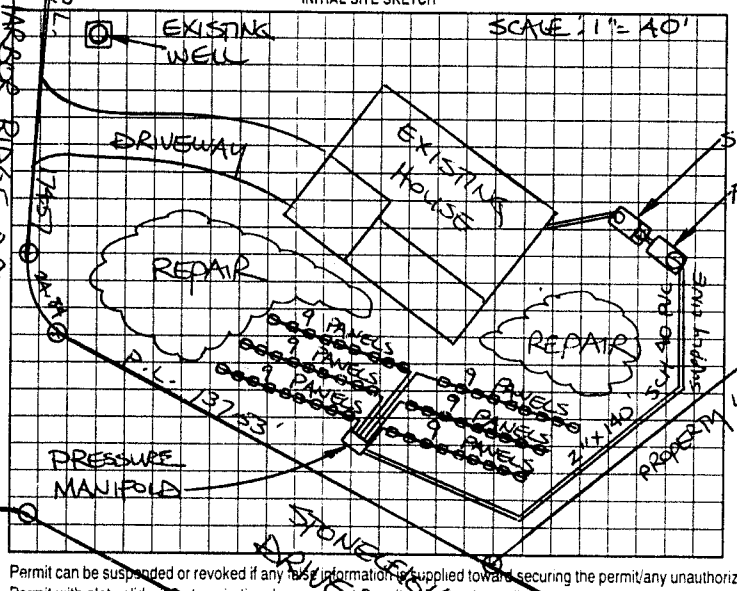

AS BUILT SKETCH

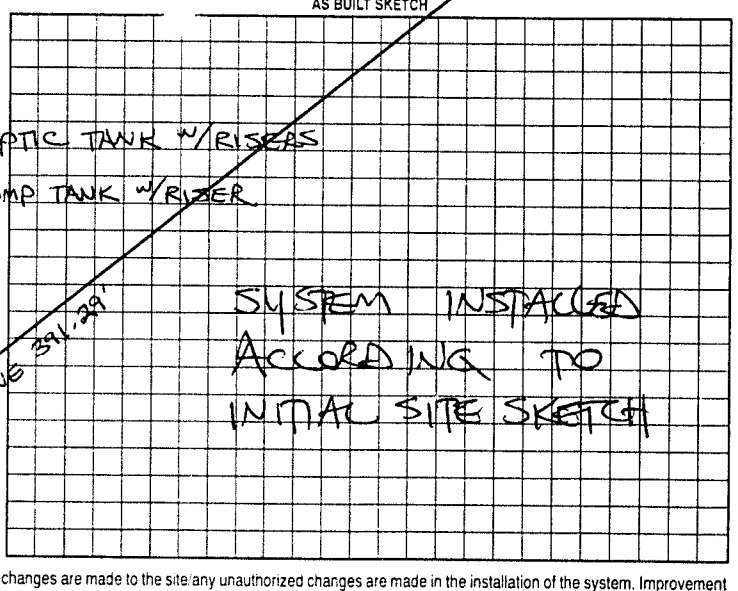

Permit can be suspended or revoked if any false information is supplied toward securing the permit/any unauthorized changes are made to the site/any unauthorized changes are made in the installation of the system. Improvement Permit with plat valid without expiration. Improvement Permit with site plan valid for sixty months. Authorization to Construct is valid for a period equal to that of Improvement Permit – not to exceed sixty months.

Signed: [signature] date 8-27-01 Installed by: A-1 BACKHOE

Improvement Permit by: STEVE HEDRICK date 8-25-01 Operation Permit by: STEVE HEDRICK date 10-25-01

Authorization to Construct by: STEVE HEDRICK date 8-25-01 Existing System Inspection by: _____ date _____

HEALTH DEPT. COPY: WHITE OWNER COPY (FINAL): YELLOW OWNER COPY (INITIAL): PINK