IREDELL COUNTY HEALTH DEPARTMENT

STATESVILLE 704-878-5305 MOORESVILLE 704-664-5281

IMPROVEMENT PERMIT / AUTHORIZATION TO CONSTRUCT / OPERATION PERMIT / EXISTING SYSTEM INSPECTION

PERMIT# 131679 PIN# 4711228402 DATE 10-26-05

OWNER OR CONTRACTOR Lester & Ruth Carnathan PHONE: Business 704 799 1233 Home 704 528 8209

ADDRESS 197 Harbor Ridge Statesville, NC

LOCATION West on Buffalo Shoals (L) on Laurel Cove (R) into Harbor Watch (R) on Harbor Watch Dr. (L) on Harbor Ridge - Property on left

SUBDIVISION Harbor Watch BLOCK / SECTION V LOT 124 LOT AREA 1.891 Acre SITE CLASS. PS DESIGN FLOW 360 L.T.A.R. .3


Septic Tank: 1000 Gallons; STB 821 Date 3-11-14
Pump Tank: N/A Gallons; PT N/A Date N/A
Pump Make: N/A Model Poly Vault Serial No. PL-68
Nitrification Field: No Fields 1 Square Feet 1200 Linear Feet 400
No Lines 3 Trench Width 3 Max Trench Bottom Depth 30 Gravel Depth 12

☒ New System ☐ Repair System Type: I, (II), III, IV, V, VI
System Description: Conventional - Gravity
Repair System Description: 25% Reduction Gravity
Maintenance Agreement Required: ☐ Yes ☒ No

☒ House/Mod. Home No. Bedrooms 3
☐ Mobile Home No. Bathrooms 2
☐ Business No. Employees
☐ Other
☐ Slab ☐ Crawl Space ☒ Basement w/plumbing ☐ Basement wo/plumbing

Water Supply: ☒ Individual ☐ Public ☐ Community

Comments:/Conditions:

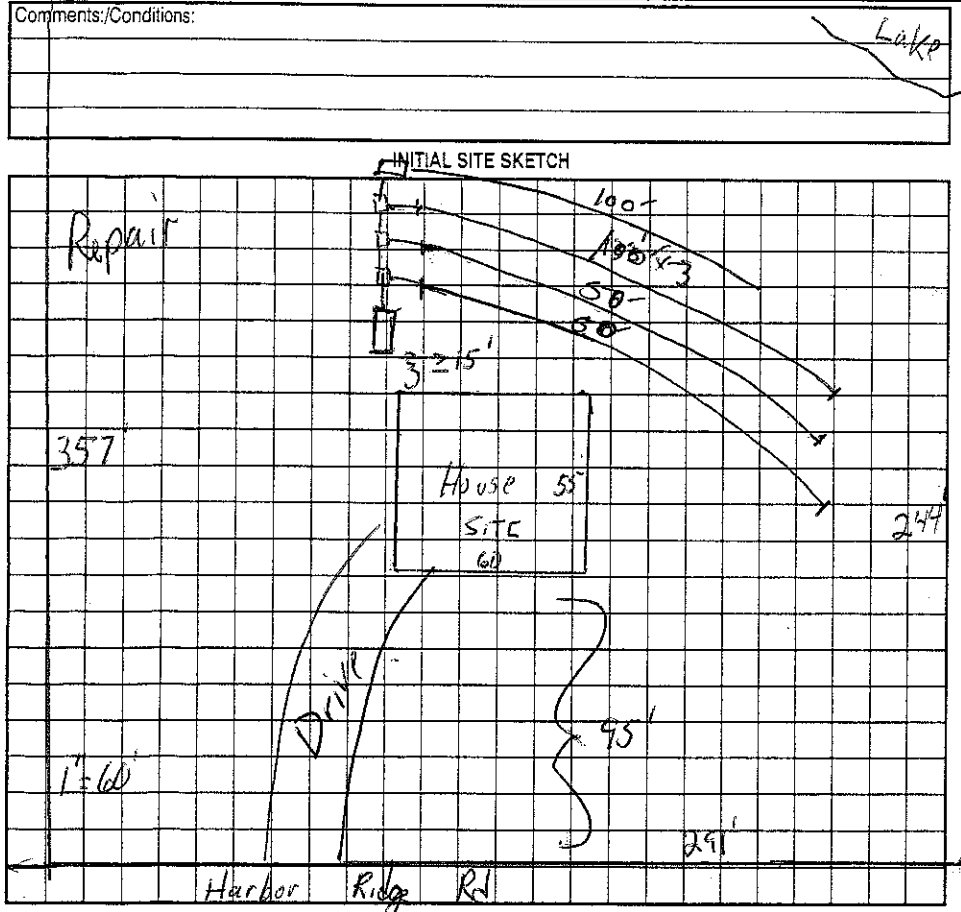

Comments:/Conditions: 25% Reduction Gravity system also Okid for initial - 300 ft total

AS BUILT SKETCH

No construction of house at time of installation. Installed as drawn

Permit can be suspended or revoked if any false information is supplied toward securing the permit/any unauthorized changes are made to the site/any unauthorized changes are made in the installation of the system. Improvement Permit with plat valid without expiration. Improvement Permit with site plan valid for sixty months. Authorization to Construct is valid for a period equal to that of Improvement Permit – not to exceed sixty months.

Signed: Lester Carnathan date 10/28/05 Installed by: Tim Summey

Improvement Permit by: James Deaver date 10-26-05 Operation Permit by: [signature] date 05/20/19

Authorization to Construct by: James Deaver date 10-26-05 Existing System Inspection by: date

HEALTH DEPT. COPY: WHITE OWNER COPY (FINAL): YELLOW OWNER COPY (INITIAL): PINK