IREDELL COUNTY HEALTH DEPARTMENT

STATESVILLE 704-878-5305 MOORESVILLE 704-664-5281

IMPROVEMENT PERMIT / AUTHORIZATION TO CONSTRUCT / OPERATION PERMIT / EXISTING SYSTEM INSPE

PERMIT# 073302 PIN# 4711316122 PT DATE 6/11

OWNER OR CONTRACTOR Lake Norman Properties PHONE: Business (704) 847-6006 Home

ADDRESS P.O. Box 1627 Matthews NC 28106

LOCATION Buffalo Shoals Tl Laurel Cove TR Harbor-gate TR Harborwatch Tl Harbor Ridge on Left

SUBDIVISION Harborwatch BLOCK / SECTION 4 LOT 123 LOT AREA 2.381 Acre SITE CLASS PS DESIGN FLOW 360 gpd L.T.A.R. .3

Septic Tank: 1000 Gallons; STB 1012 Date 6-11-00
Pump Tank: Gallons; PT Date
Pump Make: Model Serial No.
Nitrification Field: No Fields 1 Square Feet 1200' Linear Feet 400
No Lines 4 at 100' Trench Width 36" Max Trench Bottom Depth 34-36" Gravel Depth 12"

[X] New System [ ] Repair System Type: [ ] II, III, IV, V, VI
System Description: Gravity-Conventional
Repair System Description: Same
Maintenance Agreement Required: [ ] Yes [X] No

[X] House/Mod. Home No. Bedrooms 3
[ ] Mobile Home No. Bathrooms 2
[ ] Business No. Employees
[ ] Other


[ ] Slab [X] Crawl Space [ ] Basement w/plumbing [ ] Basement wo/plumbing

Water Supply: [X] Individual [ ] Public [ ] Community


Comments:/Conditions: Keep Septic System 5' from House, 10' from DL & 100' from Well

Comments:/Conditions: Installed as shown Drop Boxes used

INITIAL SITE SKETCH

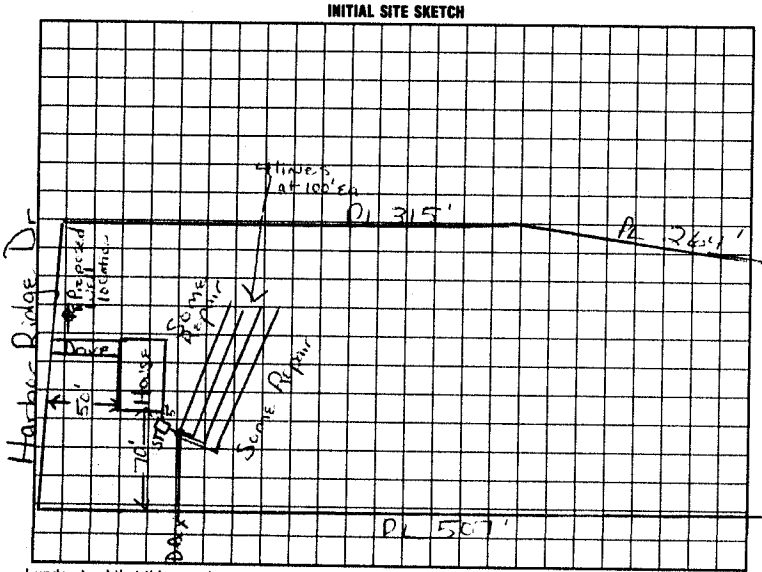

AS BUILT SKETCH

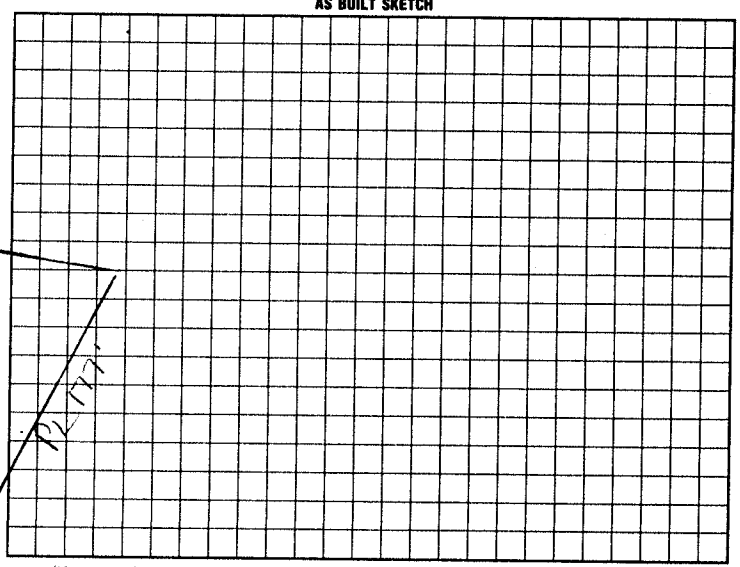

I understand that this permit can be suspended or revoked if any false information is supplied toward securing the permit/any unauthorized changes are made to the site/any unauthorized changes are made in the installation of the system. Improvement Permit with plat valid without expiration. Improvement Permit with site plan valid for sixty months. Authorization to Construct is valid for a period equal to that of Improvement Permit – not to exceed sixty months.

Signed: date 6-16-98 Installed by: David Yount

Improvement Permit by: date 6/11/98 Operation Permit by: date 8-22-00

Authorization to Construct by: date Existing System Inspection by: date

HEALTH DEPT. COPY: WHITE INSPECTION COPY (FINAL): GREEN OWNER COPY (FINAL): YELLOW INSPECTION COPY (INITIAL): PINK OWNER COPY (INITIAL): GOLD