IREDELL COUNTY HEALTH DEPARTMENT

STATESVILLE 704-878-5305 MOORESVILLE 704-664-5281

IMPROVEMENT PERMIT / AUTHORIZATION TO CONSTRUCT / OPERATION PERMIT / EXISTING SYSTEM INSPECTION

PERMIT# 125717 PIN# 4711-23-1787 DATE 2-2-05

OWNER OR CONTRACTOR HESTER HOMES PHONE: Business 704-400-5489 Home 704-366-4742

ADDRESS 6548 SHUFTS BORY RD CHARLOTTE, N.C. 28270

LOCATION BUFFALO SHOALS (E) LAUREL COVE (R) HARBORGATE DR (R) HARBOR WATCH DR (L) HARBOR RIDGE (R) WIND BLUFF AT END IN CUL-DE-SAC

SUBDIVISION HARBOR WATCH BLOCK / SECTION IV LOT 160 LOT AREA 5.272 AC SITE CLASS. PS DESIGN FLOW 480 L.T.A.R. .3

Septic Tank: 1000 Gallons; STB 1012 Date 5-705
Pump Tank: ____ Gallons; PT ____ Date ____
Pump Make: ____ Model ____ Serial No. ____
Nitrification Field: No Fields 1 Square Feet EQ=1600 Linear Feet 400'
No Lines 4X100' Trench Width 36" Max Trench Bottom Depth 36" Gravel Depth N/A

[X] New System [ ] Repair System Type: I, II, [III] IV, V, VI
System Description: GRAV 250/0 PRODUCT
Repair System Description: SAME
Maintenance Agreement Required: [ ] Yes [X] No


[X] House/Mod. Home No. Bedrooms 4
[ ] Mobile Home No. Bathrooms 3
[ ] Business No. Employees ____
[ ] Other ____
[ ] Slab [ ] Crawl Space [X] Basement w/plumbing [ ] Basement wo/plumbing

Water Supply: [X] Individual [ ] Public [ ] Community
WELL

Comments:/Conditions: (1) INSTALL LINES ON CONTOURS MAINTAIN SETBACKS (2) EACH OF THE ADJOINING LOTS PERMITS ARE EXPIRED & ARE IN THE EXPIRED FILES (3) GRADE BASEMENT SO THAT THE TANK CAN BE INSTALLED WITH

Comments:/Conditions: SETBACKS MAINTAINED & KEEP FILL TO DRAW FIELD LINE LENGTHS = 1 = 90' TUFF TITE FILL MATERIAL 2 = 100' V'D LINE #2 3 = 90' 4 = 120'

INITIAL SITE SKETCH 1" = 100'

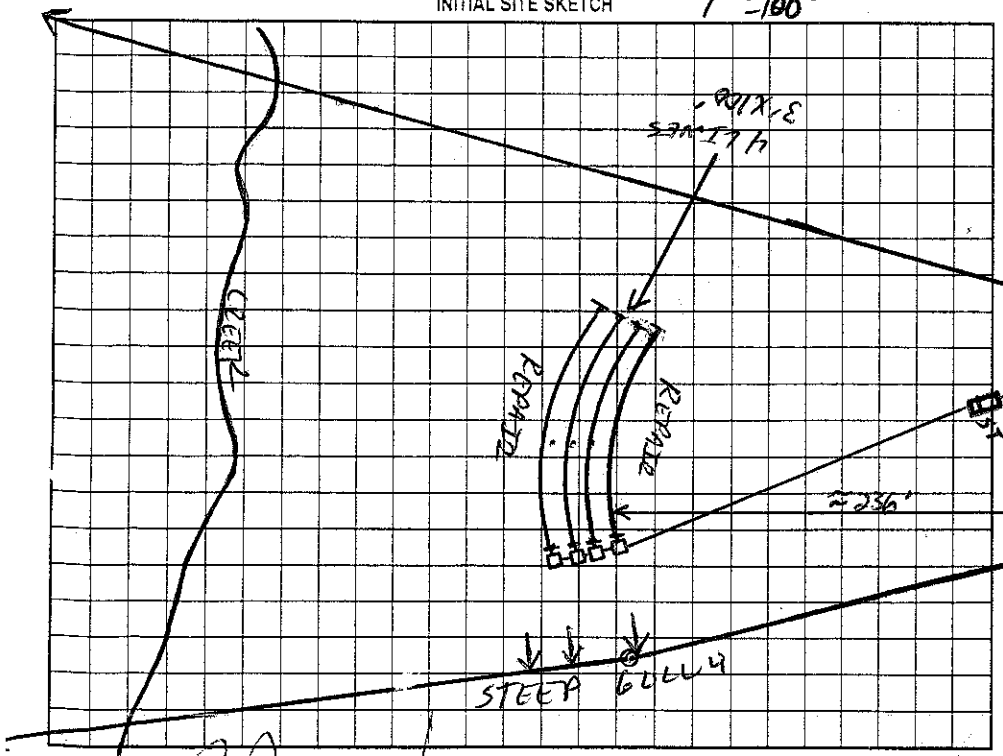


AS BUILT SKETCH

- W/D SYSTEM INSTALLED DURING WET SOIL CONDITIONS
- CALLED & LEFT MESSAGE TO BUILDER ON 1-11-06 ABOUT BEDROOM ISSUES.
- LEFT MESSAGE AGAIN ON 1-13-06
- MET BUILDER ON 1-18-06, SYSTEM SIZED FOR 4 BEDROOMS. ONLY PRESENTLY 3 BEDROOMS WITH UNFINISHED BASEMENT, SEE COMMENTS

WIND BLUFF COURT

WIND BLUFF LOT HOUSE PLAN SHEET 2 C 1-18-06

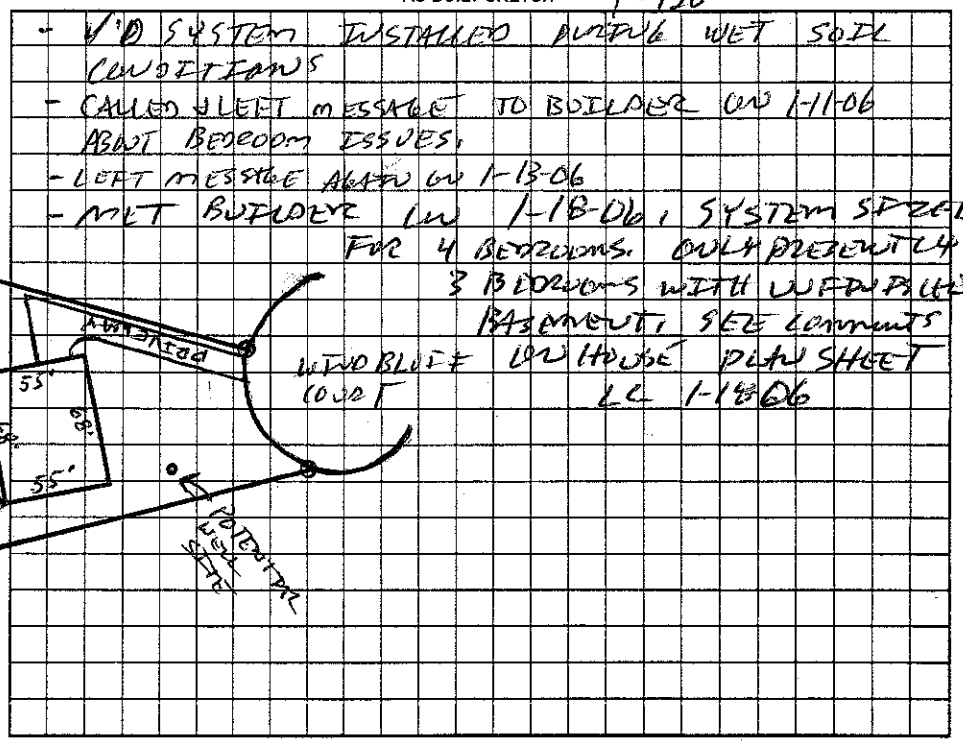

Permit can be suspended or revoked if any false information is supplied toward securing the permit/any unauthorized changes are made to the site/any unauthorized changes are made in the installation of the system. Improvement Permit with plat valid without expiration, Improvement Permit with site plan valid for sixty months. Authorization to Construct is valid for a period equal to that of Improvement Permit – not to exceed sixty months.

Signed: [signature] date 2-8-05 Installed by: A-1 BACKHOE

Improvement Permit by: [signature] date 2-8-05 Operation Permit by: [signature] date 1-18-06

Authorization to Construct by: [signature] date 2-8-05 Existing System Inspection by: ____ date ____

HEALTH DEPT. COPY: WHITE OWNER COPY (FINAL): YELLOW OWNER COPY (INITIAL): PINK

