Note: This permit voids permit dated 11/29/00

(Owe # 500.00)

IREDELL COUNTY HEALTH DEPARTMENT

STATESVILLE 704-878-5305 ✓ MOORESVILLE 704-664-5281

IMPROVEMENT PERMIT / AUTHORIZATION TO CONSTRUCT / OPERATION PERMIT / EXISTING SYSTEM INSPECTI

PERMIT# 073301 PIN# 4711 361 22PT 4711-23-9025 DATE 9/20/01

OWNER OR CONTRACTOR Tim Pickering PHONE: Business Home (704) 573-3178

ADDRESS 6516 St Ox Meade Drive Charlotte N.C. 28227

LOCATION 016 Mfo Rd. (R) Buffalo Shoals, (L) Laurel Cove, (R) Harbor gate, (R) Harbor watch, (L) Harbor Ridge on Left

SUBDIVISION Harbor watch BLOCK / SECTION 4 LOT 121 LOT AREA 2.84 Ac SITE CLASS. T5 DESIGN FLOW 600 L.T.A.R. 0.3

Septic Tank: 1,500 Gallons; STB 338 Date 7-15-01

Pump Tank: 1,500 Gallons; PT 338 Date 6-26-01

Pump Make: Myers Model ME505 Serial No. 401

Nitrification Field: No Fields 1 Square Feet Equivalent 2000 Linear Feet 335

No Lines 45 Trench Width 24" Max Trench Bottom Depth 36" ~~Gravel Depth~~ 56 tons Sand

☒ New System ☐ Repair System Type: I, II, III, (IV) V, VI

System Description: Low Pressure PVC

Repair System Description: LP PVC

Maintenance Agreement Required: ☒ Yes ☐ No

☒ House/Mod. Home No. Bedrooms 5

☐ Mobile Home No. Bathrooms 4½

☐ Business No. Employees

☐ Other


☐ Slab ☐ Crawl Space ☒ Basement w/plumbing ☐ Basement wo/plumbing

Water Supp ☐ Individu. ☐ Public ☒ Commu


Comments:/Conditions: (1) Install Lines on Contour (2) Maintain proper setbacks (3) A contract shall be executed between the Syster Owner and a management entity prior to the issuance of an Operation Permit. (4) Install 77 panels w 5/32 Holes Pipe

Comments:/Conditions: (1) Installed 5 Lines – #1-65', #2-90', #3-75', #4-60', #5-55' (2) Pressure Check-okay, Lines-okay, Electric on 9/27/01 sgf: Alarm okay 9/28-01

INITIAL SITE SKETCH

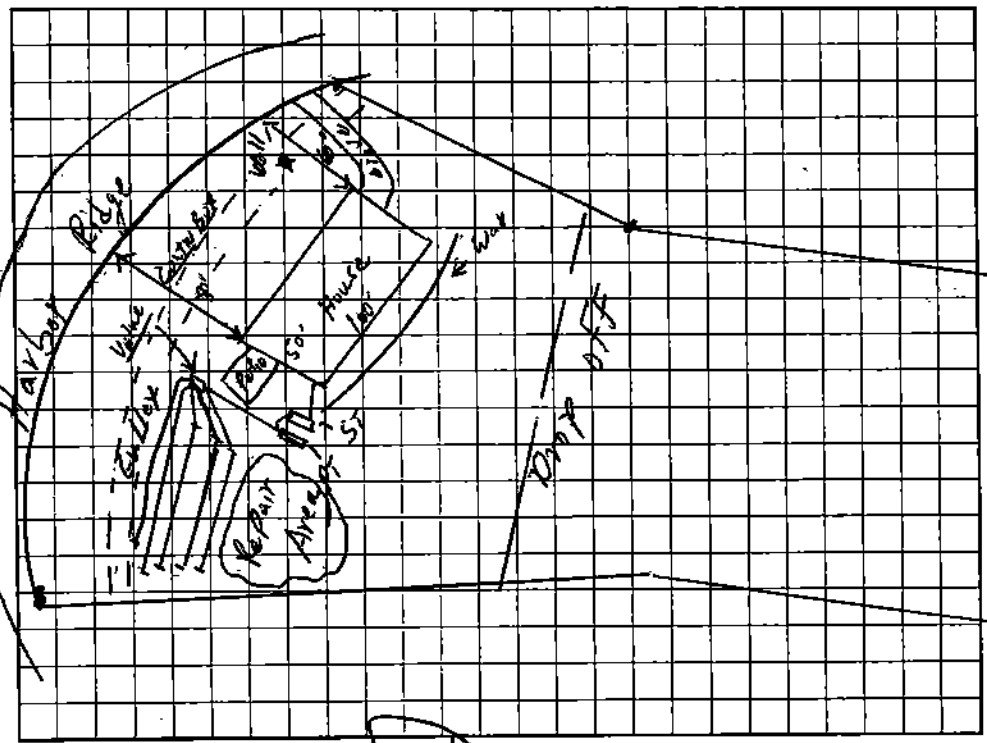

AS BUILT SKETCH

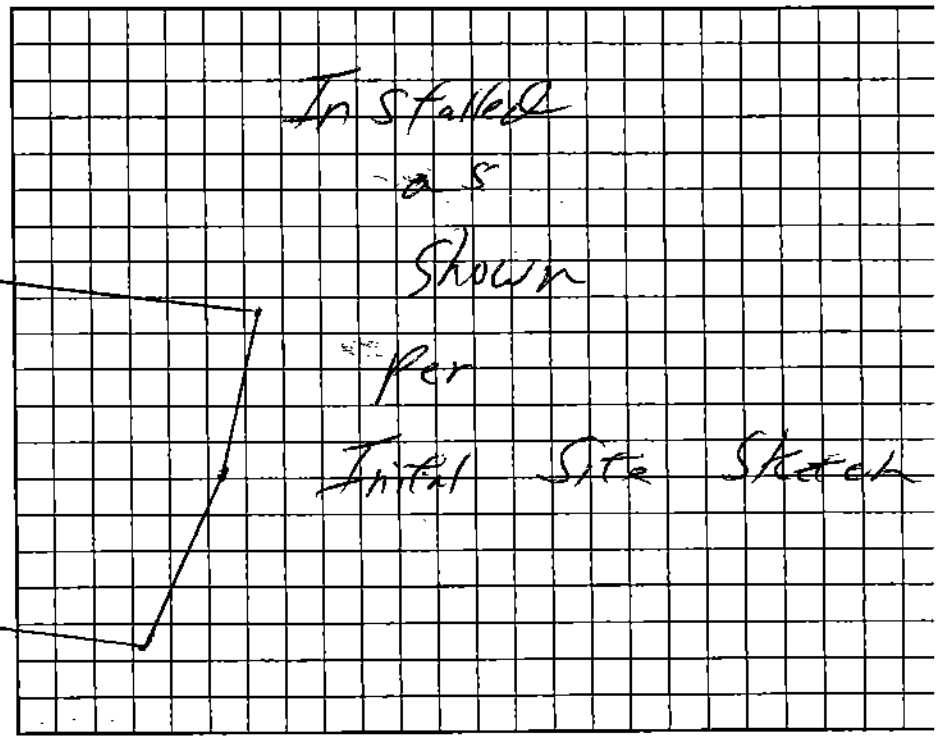

Permit can be suspended or revoked if any false information is supplied toward securing the permit/any unauthorized changes are made to the site/any unauthorized changes are made in the installation of the system. Improve Permit with plat valid without expiration. Improvement Permit with site plan valid for sixty months. Authorization to Construct is valid for a period equal to that of Improvement Permit – not to exceed sixty months.

Signed: [illegible] date 9-21-01 Installed by: R+H Inc 9-28-01

Improvement Permit by: William O. Johnson date 9/20/01 Operation Permit by: William O. Johnson date 9-28-

Authorization to Construct by: William O. Johnson date 9/20/01 Existing System Inspection by: date

HEALTH DEPT COPY: WHITE OWNER COPY (FINAL): YELLOW OWNER COPY (INITIAL): PINK