IREDELL COUNTY HEALTH DEPARTMENT

STATESVILLE 704-878-5305 (c1) MOORESVILLE 704-664-5281

IMPROVEMENT PERMIT / AUTHORIZATION TO CONSTRUCT / OPERATION PERMIT / EXISTING SYSTEM INSPECTION

PERMIT# 125691 PIN# 4711-24-2935 DATE 1-24-05

OWNER OR CONTRACTOR RICHARD M. LEPORA PHONE: Business Home 704-528-4948

ADDRESS 119 TERRY SPRINGS LANE, STATESVILLE, NC 28677

LOCATION BUFFALO SHOALS ROAD TO TERRY SPRINGS ROAD, ABOUT 0.5 MILE BACK TO END,

SUBDIVISION BLOCK / SECTION LOT LOT AREA 17.15 ACRES SITE CLASS. PS DESIGN FLOW 360 L.T.A.R. 0.30 GPD/FT²

Septic Tank: 1000 Gallons; STB 1012 Date 11-27-05
Pump Tank: Gallons; PT Date
Pump Make: Model 60 PP 300 Serial No. 1200
Nitrification Field: No Fields 1 Square Feet 1200 Linear Feet 400
No Lines FOUR 3 Trench Width 36" Max Trench Bottom Depth 36" Gravel Depth 12"

☑ New System ☐ Repair System Type: I, II, III, IV, V, VI
System Description: 256 CONVENTIONAL, GRAVITY
Repair System Description: CONVENTIONAL, GRAVITY
Maintenance Agreement Required: ☐ Yes ☑ No


☑ House/Mod. Home No. Bedrooms 3
☐ Mobile Home No. Bathrooms
☐ Business No. Employees
☐ Other
☐ Slab ☐ Crawl Space ☑ Basement w/plumbing ☐ Basement wo/plumbing

Water Supply:
☑ Individual
☐ Public
☐ Community
WELL

Comments:/Conditions: KEEP SYSTEM MINIMUM 100 FEET FROM WELL.

Comments:/Conditions: SEPTIC TANK WITH MARKER INSTALLED USING "THETIS" FILTER
1ST LINE INSTALLED 6-13-06 USING SIPHON

INITIAL SITE SKETCH

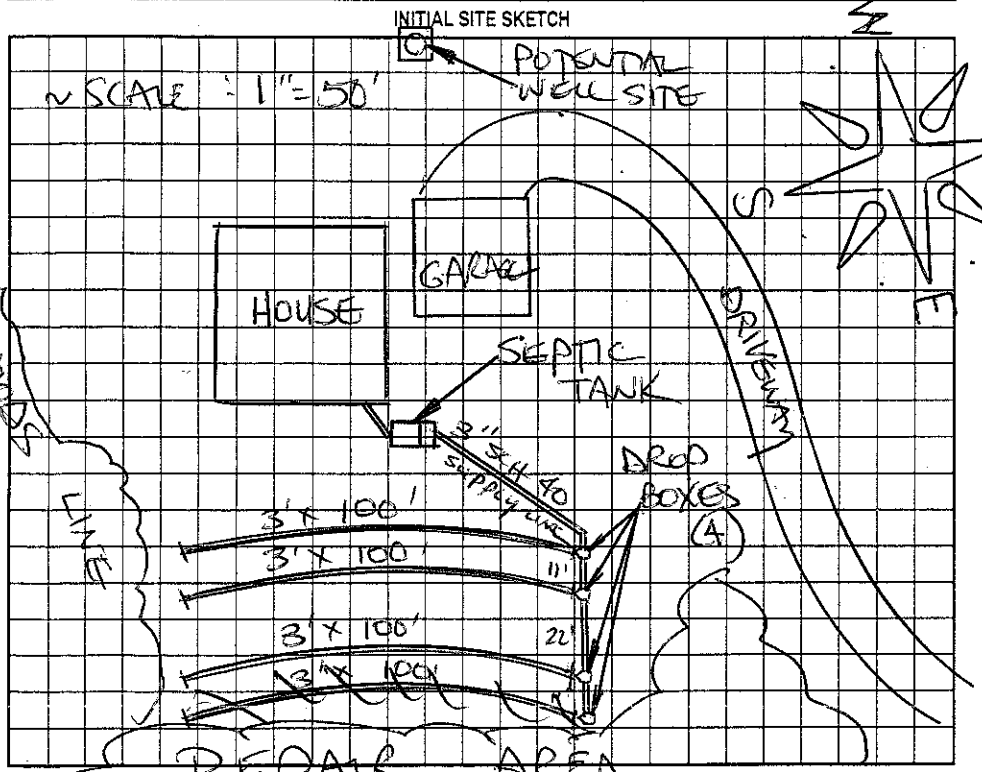

AS BUILT SKETCH

SYSTEM INSTALLED ACCORDING TO INITIAL SITE SKETCH USING 75 QUICK-4 INFILTRATOR CHAMBERS AS "ACCEPTED" SYSTEM

Permit can be suspended or revoked if any false information is supplied toward securing the permit/any unauthorized changes are made to the site/any unauthorized changes are made in the installation of the system. Improvement Permit with plat valid without expiration. Improvement Permit with site plan valid for sixty months. Authorization to Construct is valid for a period equal to that of Improvement Permit – not to exceed sixty months.

Signed: Richard M. Lepora date 1-24-05 Installed by: A-1 BACKHOE

Improvement Permit by: STEVE HENDRICK date 1-24-05 Operation Permit by: STEVE HENDRICK date 6-19-06

Authorization to Construct by: STEVE HENDRICK date 1-24-05 Existing System Inspection by: date

HEALTH DEPT. COPY: WHITE OWNER COPY (FINAL): YELLOW OWNER COPY (INITIAL): PINK