IREDELL COUNTY HEALTH DEPARTMENT

STATESVILLE 704-878-5305 MOORESVILLE 704-664-5281

IMPROVEMENT PERMIT / CERTIFICATE OF COMPLETION / OPERATION PERMIT / EXISTING SYSTEM INSPECTION

PROPERTY DESCRIPTION NO. 2/86-5 57625 DATE 8-23-95 TAX MAP NO. 3Q-A-pt84 Watershed: ☑ Yes ☐ No

OWNER OR CONTRACTOR William B. Troutman II PHONE: Business _____ Home 528-5509 ~~WSII~~ PA

ADDRESS 2444 Buffalo Shoals Rd

LOCATION Buffalo Shoals Rd .6 mi on Rt Past Pineville Rd on Baxter Ln.

SUBDIVISION Troutman Property BLOCK / SECTION _____ LOT _____ LOT AREA 8 acres SITE CLASS. PS DESIGN FLOW 360 L.T.A.R. 1.3

Septic Tank: 1000 Gallons; STB 75% Date 8-21-98 ☑ New System ☐ Repair System Type: I, II, III, IV, V, VI

Pump Tank: _____ Gallons; PT _____ Date _____

Pump Make: _____ Model _____ Serial No. _____

Nitrification Field: No Fields 1 Square Feet 1200 Linear Feet 400

No Lines 4 Trench Width 36" Max Trench Bottom Depth 36" Gravel Depth 12"

System Description: Conv. Ramsey

Repair System Description: " "

Maintenance Agreement Required: ☐ Yes ☐ No

☐ House/Mod. Home ☑ Mobile Home ☐ Business ☐ Other

No. Bedrooms 3 No. Bathrooms 2 No. Employees _____


☐ Slab ☑ Crawl Space ☐ Basement w/plumbing ☐ Basement wo/plumbing

Water Supply: ☐ Individual ☐ Community ☐ Public

Comments:

Comments:

INITIAL SITE SKETCH

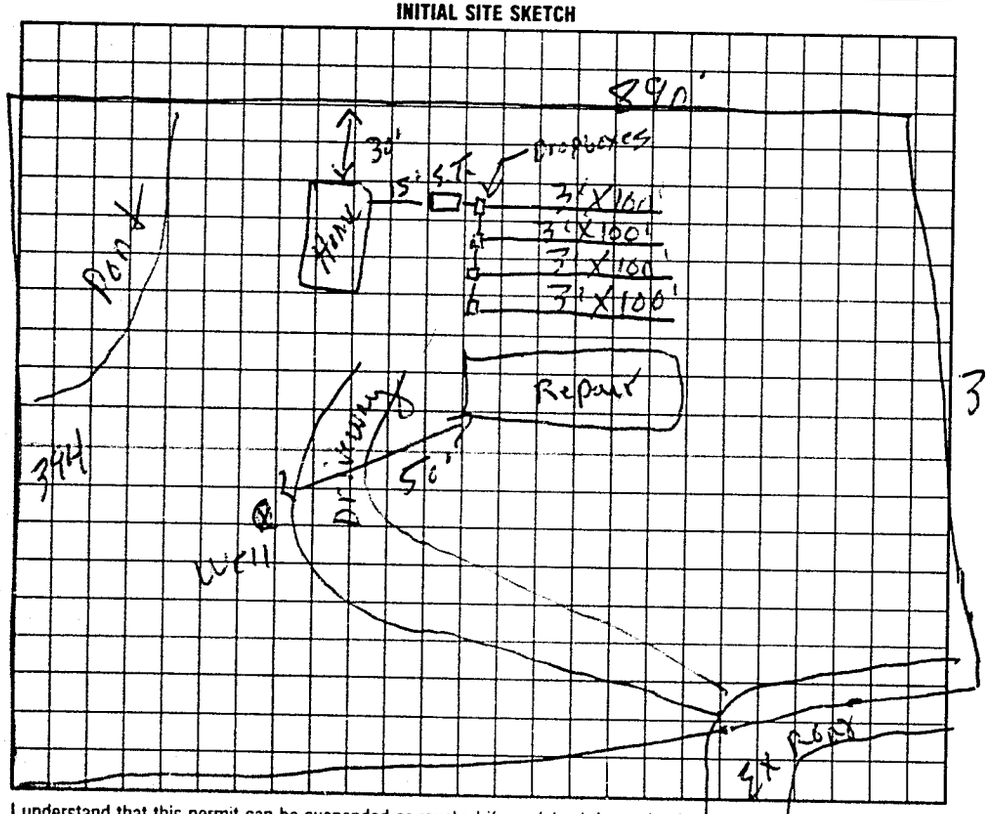

AS BUILT SKETCH

Same as initial Sketch

I understand that this permit can be suspended or revoked if any false information is supplied toward securing the permit/any unauthorized changes are made to the site/any unauthorized changes are made in the installation of the system.

Signed: X William B. Troutman

Improvement Permit by: P.C. Moore date 8-23-95

Existing System Inspection by: _____ date _____

Installed by: Charlie Brice

Certificate of Completion by: _____ date _____

Operation Permit by: P.C. Moore date 10-19-98

HEALTH DEPT COPY: WHITE INSPECTION COPY (FINAL) GREEN OWNER COPY (FINAL) YELLOW INSPECTION COPY (INITIAL) PINK OWNER COPY (INITIAL) GOLD

8 0 9 0 0