IREDELL COUNTY HEALTH DEPARTMENT

Statesville Office (704) 878-5305 Mooresville Office (704) 660-3625 PERMIT # 200759

IMPROVEMENT PERMIT / AUTHORIZATION TO CONSTRUCT / OPERATION PERMIT / EXISTING SYSTEM

PIN # 4711310191

APPLICANT: Christopher Bunn APPLICANT ADDRESS: 159 Elba Dr. Mooresville

SITE ADDRESS: 120 Northstone Dr. - Statesville PHONE: 570-919-0080 ALT. PHONE: N/A

SITE DIRECTIONS: Buffalo Shoals Rd to Laurel Cove Rd, TR Harbor Gate TL Harborwatch TR Northstone Dr.

SUBDIVISION: Harbor Watch SECTION: 5 LOT # 97 LOT AREA: 1.133 acres DESIGN FLOW: 480gpd L.T.A.R.: 0.275


Septic Tank	1000 (gal)	STB	2071	Date	InRilitator 10/6	☑ New System ☐ Repair ☐ Expansion	System Type: I II III IV V VI	☑ Residence	No. Bedrooms 4
Pump Tank	(gal)	PT		Date		System Description:	75% Reduction	☐ Business	No. Persons 8
Pump Make		Model		Serial #		Repair System Description:	75% Reduction	☐ Other	No. Employees
# Nitrification Fields	1	# Lines	3	Linear Ft:	436	Maintenance Agreement Required:	☐ YES ☑ NO	☑ Slab	☐ Crawl Space
Trench Width	36"	Max. Trench Bottom Depth	36"	Gravel Depth	N/A		☑ GRAVITY ☐ PRESSURE	☑ Basement w/plumbing	☐ Basement w/o plumbing

Water Supply: ☑ Private ☐ Public ☐ Community


Comments / Conditions: Install a 75% Reduction system on contour with serial distribution. Do NOT CUT for Basement within 15' of septic area.

*3/9/2017. InRilitator Products installed = 441Ft / well not installed yet

INITIAL SITE SKETCH

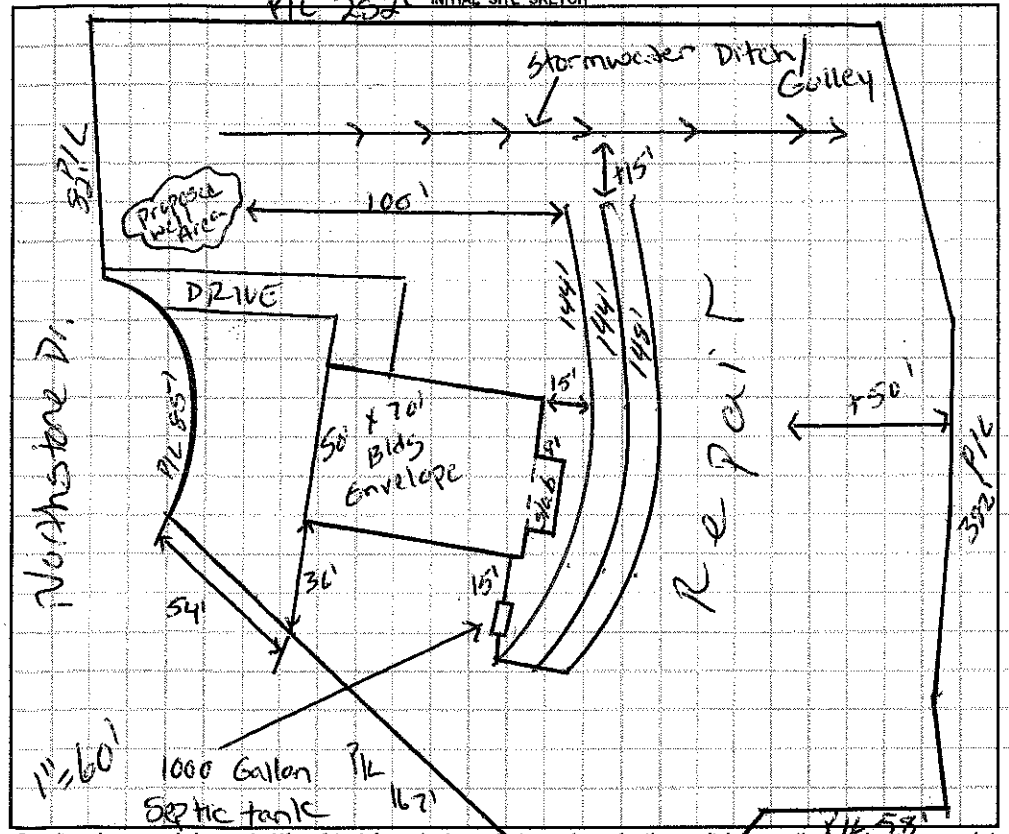

AS BUILT SKETCH

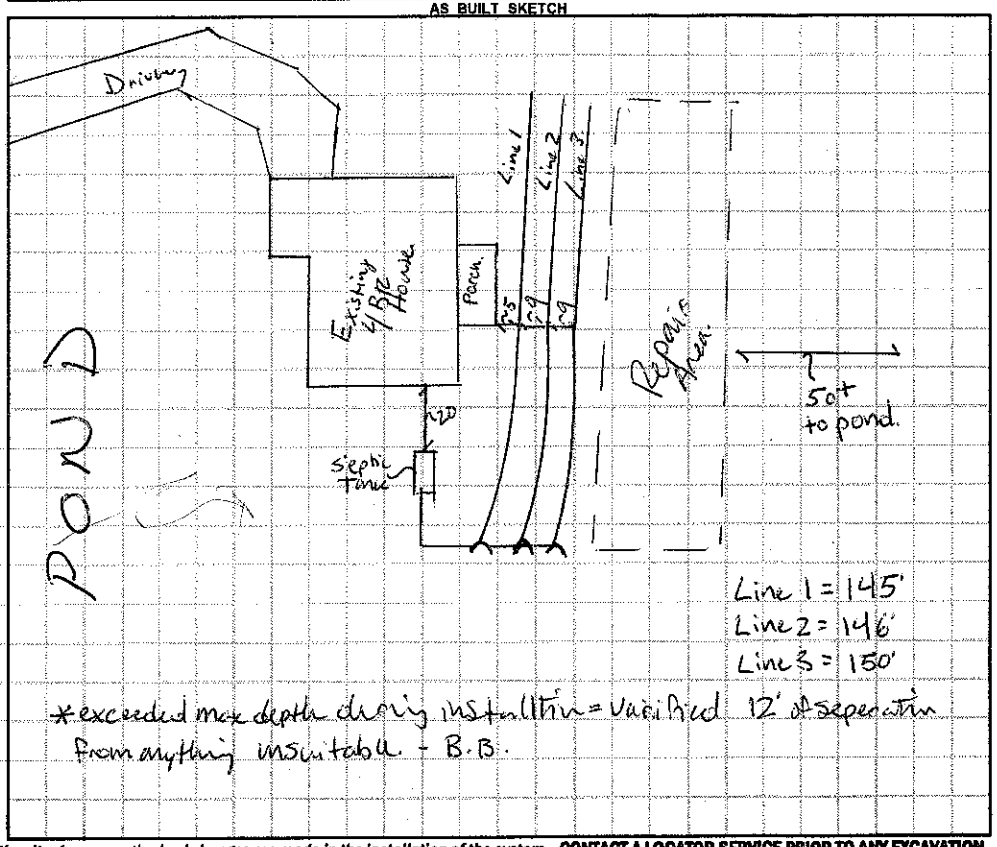

Permit can be suspended or revoked if any false information is supplied toward securing the permit / any unauthorized changes are made to the site / any unauthorized changes are made in the installation of the system. **CONTACT A LOCATOR SERVICE PRIOR TO ANY EXCAVATION**

☐ **IMPROVEMENT PERMIT** *with plat valid without expiration.* ☑ **IMPROVEMENT PERMIT** *with site plan valid for 60 mos.* ☑ **AUTHORIZATION TO CONSTRUCT** *valid for period equal to IMPROVEMENT PERMIT--not to exceed 60 mo.*

Owner / Applicant Signature: Judy Bellinger P/L 50' Date: 5-16-16 Installed by: Yountz Grading & Septic

IMPROVEMENT PERMIT by: Justin Henderson Date: 4-12-16 OPERATION PERMIT by: Benjamin A. Bottoms Date: 3/9/2017.

AUTHORIZATION TO CONSTRUCT by: Justin Henderson Date: 4-15-16 Existing System Inspected by: Date:

Health Dept. Copy - WHITE Applicant (Final Approval) - YELLOW Applicant (Conditional Approval) - PINK