Voids All Previous Permits

IREDELL COUNTY HEALTH DEPARTMENT

STATESVILLE 704-878-5305 MOORESVILLE 704-664-5281

IMPROVEMENT PERMIT / AUTHORIZATION TO CONSTRUCT / OPERATION PERMIT / EXISTING SYSTEM INSPECTION

PERMIT# 88896 PIN# 4711316977 DATE May 8, 2000

OWNER OR CONTRACTOR ANN GAITHER (JAMES McCORMACK PHONE: Business _____ Home 902 4918

ADDRESS 1507 Bellingham DR Mooresville NC 28117

LOCATION Buffalo Shoals West (L) Laura Cove (R) HARBOR GATE 3rd on Right

SUBDIVISION Harbor Watch BLOCK / SECTION V LOT 104 LOT AREA 1.2 SITE CLASS 15 DESIGN FLOW 360 L.T.A.R. .3

Septic Tank: 1000 Gallons; STB 1012 Date 10-20-00

Pump Tank: 1000 Gallons; PT _____ Date 11-8-00

Pump Make: Zoeller Model WE05111H Serial No 130048273

Nitrification Field: No Fields 1 Square Feet Per 1200 Linear Feet 300

No Lines 4 Trench Width 36" Max Trench Bottom Depth 30" ** Gravel Depth N/A

☑ New System ☐ Repair System Type: I, II, (III), IV, V, VI

System Description: Pump 25% Reduction

Repair System Description: Pump 50% Reduction

Maintenance Agreement Required: ☐ Yes ☑ No

☑ House/Mod. Home No. Bedrooms 3

☐ Mobile Home No. Bathrooms 3.5

☐ Business No. Employees ____

☐ Other ____


☐ Slab ☐ Crawl Space ☑ Basement w/plumbing ☐ Basement w/o plumbing

Water Supply: ☑ Individual ☐ Public ☐ Community WELL


Comments/Conditions: Keep Septic System AT LEAST 15 Ft from foundation DRAins, 50 ft from Lake, 10 ft from property Line 50 CHAMBER OR 30 HDS Sections. Inspection PORT on end of each Line. LOCATE well 100 ft from Septic. See ATTACHMENT

Comments/Conditions: ① PUMP SEPTIC TANK EVERY 3-5 YRS. ② 48 TOTAL CHAMBERS For pump information

INITIAL SITE SKETCH

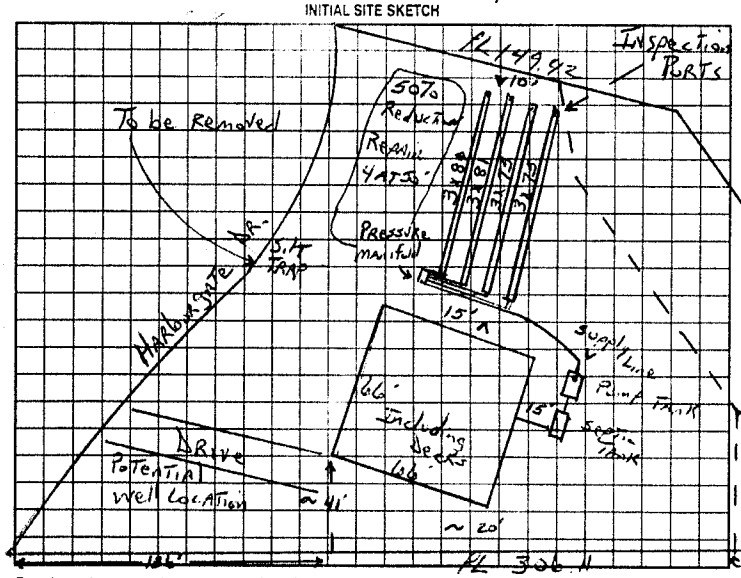

AS BUILT SKETCH

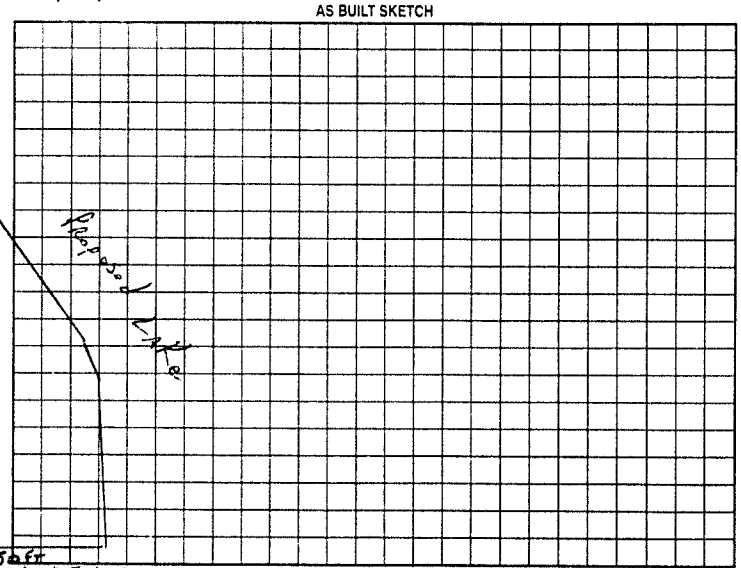

Permit can be suspended or revoked if any false information is supplied toward securing the permit/any unauthorized changes are made to the site/any unauthorized changes are made in the installation of the system. Improvement Permit with plat valid without expiration. Improvement Permit with site plan valid for sixty months. Authorization to Construct is valid for a period equal to that of Improvement Permit - not to exceed sixty months.

Signed: Bridgett Rippeth date 6-15-00 Installed by: DAVID YOUNTZ

Improvement Permit by: J.C. Potter date May 8, 2000 Operation Permit by: _____ date 3/8/01

Authorization to Construct by: J.C. Potter date May 8, 2000 Existing System Inspection by: _____ date _____

HEALTH DEPT. COPY: WHITE OWNER COPY (FINAL): YELLOW OWNER COPY (INITIAL): PINK