IREDELL COUNTY HEALTH DEPARTMENT

STATESVILLE 704-878-5305 MOORESVILLE 704-664-5281

IMPROVEMENT PERMIT / AUTHORIZATION TO CONSTRUCT / OPERATION PERMIT / EXISTING SYSTEM INSPECTION

PERMIT# 14427 PIN# 4711 31 8114 DATE 3-5-08

OWNER OR APPLICANT MELISSA WIKE PHONE: Business 704-573-7607 Home 704-607-6588/704-562-5039

ADDRESS 698 REBECCA JANE Drive Mooresville NC 28115

LOCATION BUFFALO SHOALS (L) LAUREL COVE (R) HARBOR GATE (L) HARBOR WATCH Drive 4th LOT ON RT

SUBDIVISION HARBOR WATCH BLOCK / SECTION III LOT 91 LOT AREA 69,624 sq ft SITE CLASS. PS DESIGN FLOW 480 L.T.A.R. .3 GPD/FT2

Septic Tank: 1000 Gallons; STB 1000 Date 7-15-08
Pump Tank: _____ Gallons; PT _____ Date _____
Pump Make: _____ Model _____ Serial No. _____
Nitrification Field: No Fields 1 Square Feet EBS=1600 Linear Feet 400'
No Lines FOUR Trench Width 36" Max Trench Bottom Depth 36"

☒ New System ☐ Repair ☐ Expansion System Type: I II (III) IV V VI
System Description: GRAVITY 2 SOIL REDUCTION
Repair System Description: GRAVITY 2 SOIL REDUCTION
Maintenance Agreement Required: ☐ Yes ☒ No

☒ House/Mod. Home ☐ Mobile Home ☐ Business ☐ Other
No. Bedrooms 4 No. Persons 8 No. Employees ____

Water Supply: ☒ Individual ☐ Public ☐ Community

Gravel Depth N/A ☒ Gravity ☐ Pressure ☐ Slab ☐ Crawl Space ☒ Basement w/plumbing ☐ Basement wo/plumbing

Comments/Conditions: (1) This is a Redraw Permit that replaces previously issued permit dated 8-6-07. No new soils work was performed, OLD SOILS [redacted] notes WAS USED per Iredell County's Intermediate

INITIAL SITE SKETCH

SEE ATTACHED SYSTEM DESIGN BY LORNE COOK, R.S.

Comments/Conditions: REDRAW PROCESS. (2) SYSTEM FLAGGED AND HOUSE BASEMENT D/W AT TIME OF REDRAW. * WELL IS 100'+ FROM SYSTEM & END OF LINES IS 10'+ EXACTLY FROM MARKED/SURVEYED P/L.

AS BUILT SKETCH

BOUND F. Ihr & MAYER

* CLOSEST POINT ON LAST 2 LINES WERE 9' ON CENTER

Permit can be suspended or revoked if any false information is supplied toward securing the permit/any unauthorized changes are made to the site/any unauthorized changes are made in the installation of the system. Improvement Permit with plat valid without expiration ☐ Improvement Permit with site plan valid for sixty months ☒ Authorization to Construct is valid for a period equal to that of Improvement Permit – not to exceed sixty months.

Signed: Carolyn B Horn date 3-6-08

Improvement Permit by: [signature] date 3-6-08

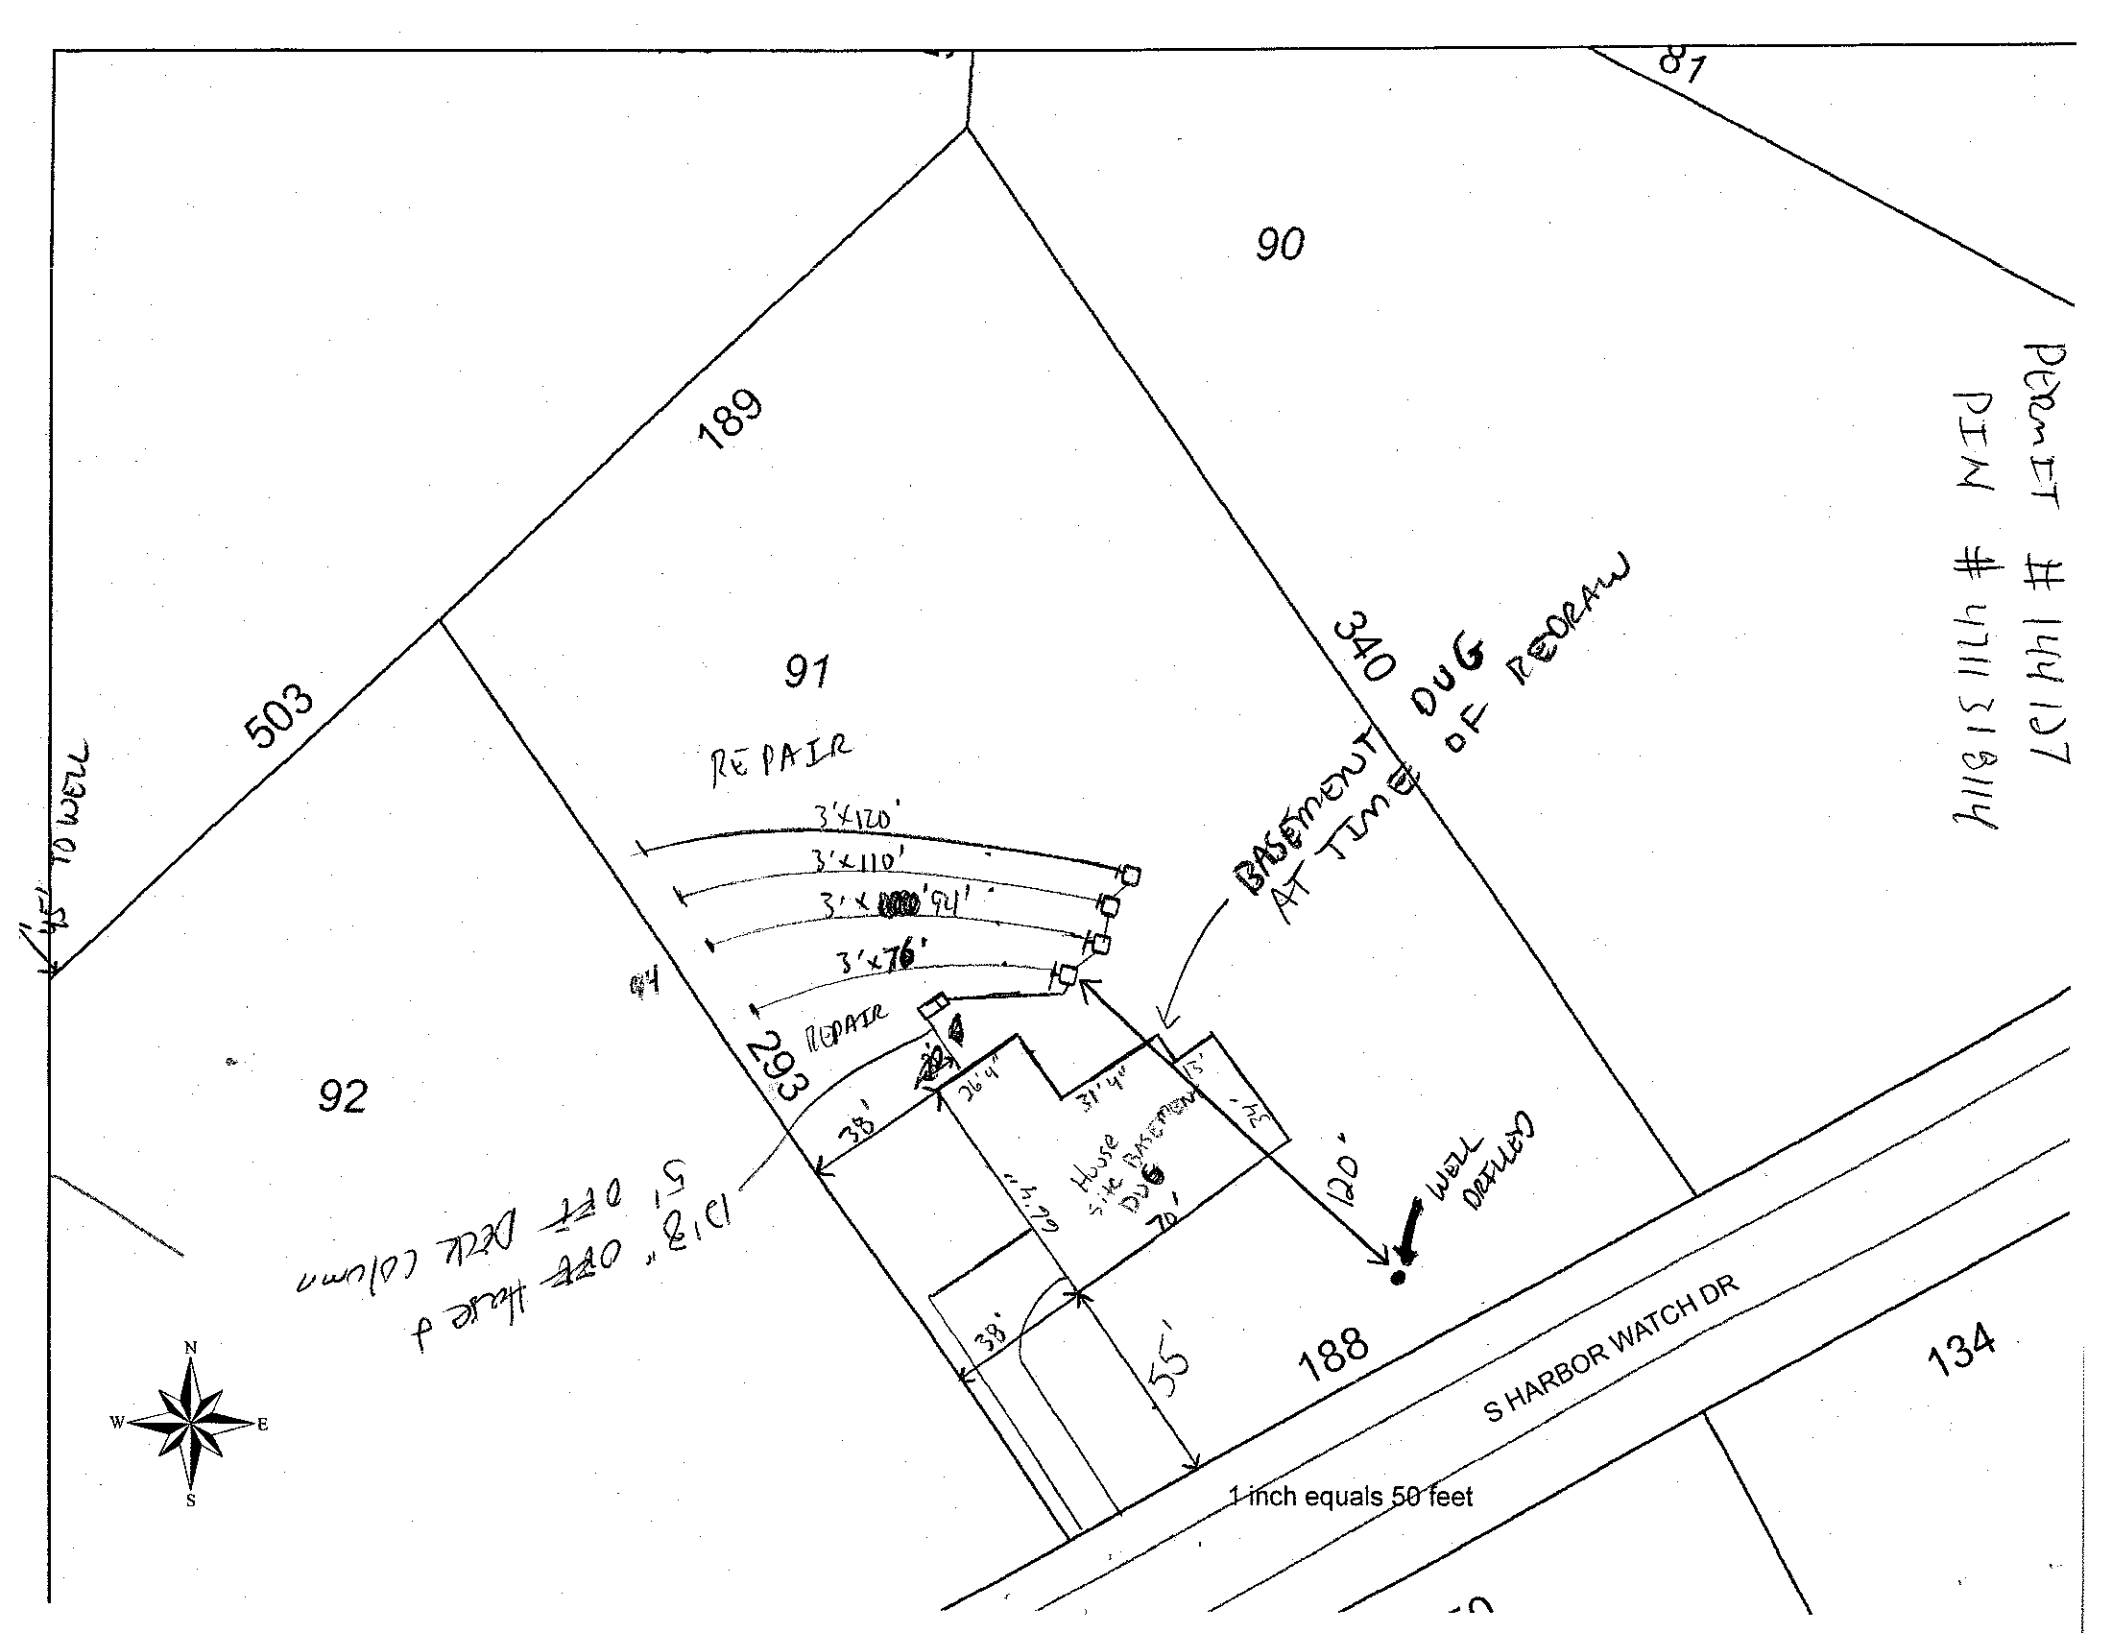
Authorization to Construct by: [signature] date 3-6-08

Installed by: Cothran & Sons Grading

Operation Permit by: [signature] date 9-18-08

Existing System Inspection by: _____ date _____

HEALTH DEPT. COPY: WHITE OWNER COPY (FINAL): YELLOW OWNER COPY (INITIAL): PINK


81
90
189
503
91
340
DUG
AT TIME OF REDRAW
BASEMENT
REPAIR
3'x120'
3'x110'
3'x94'
3'x76'
45' TO WELL
84
293
REPAIR
92
38'
26'4"
31'4"
House
site BASEMENT
DUG
70'
120'
WELL
DRILLED
38'
55'
188
S HARBOR WATCH DR
134
1 inch equals 50 feet
N
W
E
S