THIS PERMIT VOIDS PREVIOUS ISSUED 08/14/1998

IREDELL COUNTY HEALTH DEPARTMENT

STATESVILLE 704-878-5305 MOORESVILLE 704-664-5281

IMPROVEMENT PERMIT / AUTHORIZATION TO CONSTRUCT / OPERATION PERMIT / EXISTING SYSTEM INSPECTION

PERMIT# 74044 PIN# 4711 31 6122 DATE 11-15-2001

OWNER OR CONTRACTOR DANIEL DUBOIS PHONE: Business % 704.897-6006 Home

ADDRESS C/O P.O. BOX 1627 MATTHEWS N.C. 28106

LOCATION BUFFALO SHOALS RD, TL LAUREL COVE RD, TR HARBORGATE, TR HARBORWATCH, TL LAUREL RIDGE, LOT AT END

SUBDIVISION HARBOR WATCH BLOCK / SECTION V LOT 112 LOT AREA 1.093 ACRES SITE CLASS PS DESIGN FLOW 360 L.T.A.R. 0.30 GPD/FT²

Septic Tank: 1000 Gallons. STB 794 Date 9-8-01
Pump Tank: Gallons. PT Date
Pump Make: Model Serial No
Nitrification Field: No Fields 1 Square Feet 1200 Linear Feet 400
No Lines FIVE Trench Width 36" Max Trench Bottom Depth 36" Gravel Depth 12"

☑ New System ☐ Repair System Type I II III IV V VI
System Description CONVENTIONAL, GRAVITY
Repair System Description 25% REDUCTION, GRAVITY
Maintenance Agreement Required. Yes ☑ No
☐ Slab ☑ Crawl Space ☐ Basement w/plumbing ☐ Basement wo/plumbing


☑ House/Mod. Home No. Bedrooms 3
☐ Mobile Home No. Bathrooms 3
☐ Business No. Employees
☐ Other

Water Supply: ☑ Individual ☐ Public ☐ Community WELL


Comments/Conditions:

Comments/Conditions: SEPTIC TANK WITH MARKER INSTALLED USING "ZABEL" FILTER

INITIAL SITE SKETCH

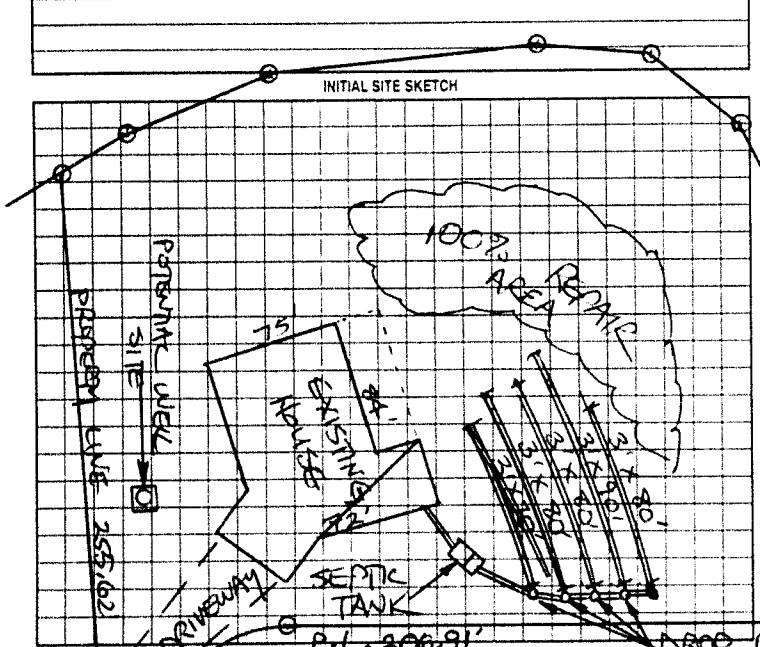

AS BUILT SKETCH

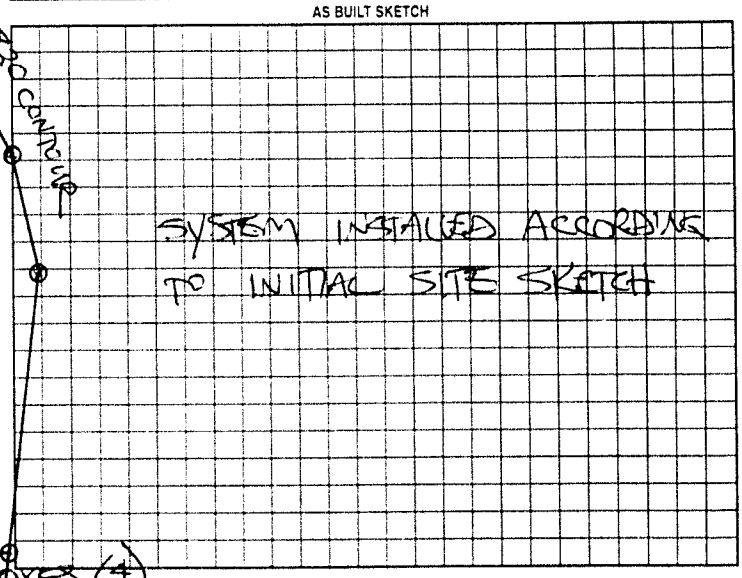

Permit can be suspended or revoked if any false information is supplied toward securing the permit, any unauthorized changes are made to the site any unauthorized changes are made in the installation of the system. Improvement Permit with plat valid without expiration. Improvement Permit with site plan valid for sixty months. Authorization to Construct is valid for a period equal to that of Improvement Permit - not to exceed sixty months.

Signed: [signature] date 11-15-01

Improvement Permit by: STEVE HEDRICK date 11-15-01

Authorization to Construct by: STEVE HEDRICK date 11-15-01

Installed by: STATESVILLE BACKHOE

Operation Permit by: STEVE HEDRICK date 11-21-01

Existing System Inspection by: date

HEALTH DEPT COPY WHITE OWNER COPY (FINAL) YELLOW OWNER COPY (INITIAL) PINK