(11:00) This Voids all Previous 2:30 issued Permits

IREDELL COUNTY HEALTH DEPARTMENT

STATESVILLE 704-878-5305 MOORESVILLE 704-664-5281

IMPROVEMENT PERMIT / AUTHORIZATION TO CONSTRUCT / OPERATION PERMIT / EXISTING SYSTEM INSPECTION

PERMIT# ~~20~~ ~~28~~ 74046 PIN# 4711316122 DATE Oct 20, 99

OWNER OR CONTRACTOR Lake Norman Properties PHONE: Business 847 6006 Home

ADDRESS PO Box 1627 Matthews NC

LOCATION Buffalo Shoals (D) Laurel Cove (H) HarborGate (R) Harborwatch (V) Laurel Ridge AT End on Right

SUBDIVISION Harbor Watch BLOCK / SECTION II LOT 113 LOT AREA 1.62 Ac SITE CLASS FS DESIGN FLOW 360 L.T.A.R. 03

Septic Tank: 1000 Gallons; STB 794 Date 4/30/cm

Pump Tank: Gallons; PT Date

Pump Make: Model Serial No.

Nitrification Field: No Fields 1 Square Feet 1200 Linear Feet 300

No Lines 4 Trench Width 36" Max Trench Bottom Depth 36" Gravel Depth N/A

[X] New System [ ] Repair System Type: I, II, (III) IV, V, VI

System Description: Gravity 25% Reduction

Repair System Description: Same

Maintenance Agreement Required: [ ] Yes [X] No

[X] House/Mod. Home No. Bedrooms 3

[ ] Mobile Home No. Bathrooms 2

[ ] Business No. Employees

[ ] Other

[ ] Slab [X] Crawl Space [X] Basement w/plumbing [ ] Basement wo/plumbing


Water Supply: [X] Individual [ ] Public [ ] Community

Comments/Conditions: Install on Contour
50 Chambers OR 30 HDS sections
Follow All set back Regulations
Keep Well 100ft OR MAX. Feasible distance from Septic System (50 ft Min.)

Comments/Conditions

1" = 50' Scale

INITIAL SITE SKETCH

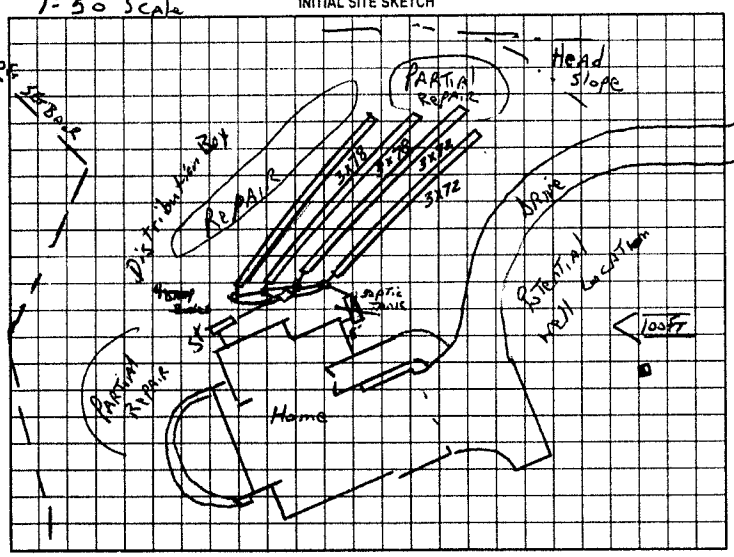

AS BUILT SKETCH

Permit can be suspended or revoked if any false information is supplied toward securing the permit/any unauthorized changes are made to the site/any unauthorized changes are made in the installation of the system. Improvement Permit with plat valid without expiration. Improvement Permit with site plan valid for sixty months. Authorization to Construct is valid for a period equal to that of Improvement Permit – not to exceed sixty months.

Signed: Jan Weddington For PAUL BORTNER date 10/27/1999 Installed by: FS Ervin

Improvement Permit by: J. Potter date Oct 20 99 Operation Permit by: Greg Mc My RST date 12/18/00

Authorization to Construct by: J. Potter date Oct 2099 Existing System Inspection by: date

HEALTH DEPT COPY: WHITE OWNER COPY (FINAL) YELLOW OWNER COPY (INITIAL) PINK