IREDELL COUNTY HEALTH DEPARTMENT

STATESVILLE 704-878-5305 (A) MOORESVILLE 704-664-5281

IMPROVEMENT PERMIT / AUTHORIZATION TO CONSTRUCT / OPERATION PERMIT / EXISTING SYSTEM INSPECTION

PERMIT# 119566 PIN# 4711-32-8686 DATE 5-19-05

OWNER OR CONTRACTOR JOHN & SUSAN PATRICK PHONE: Business 704-632-6021 Home 704-875-0588 / 704-807-4684

ADDRESS 15630 WITH FORD HALL ST HUNTERSVILLE, NC 28078

LOCATION BOBE SHOALS (L) LAUREL COVE (R) HARBOR GATE (R) HUNTERSVILLE LOT AT BOTTOM ON LEFT

SUBDIVISION HARBOR WATCH BLOCK / SECTION V LOT 109 LOT AREA 1.19 AC SITE CLASS PS DESIGN FLOW 360 L.T.A.R. .3

Septic Tank: 1000 Gallons; STB 760 Date 5-30
Pump Tank: 1000 Gallons; PT 363 Date 2-17
Pump Make: ZOELLER Model BM 153A Serial No. 153-0005
Nitrification Field: No Fields 1 Square Feet EDU=1760' Linear Feet 200'
No Lines 4 Trench Width 24" Max Trench Bottom Depth 36" Gravel Depth N/A


☒ New System ☐ Repair System Type: I, II, III, (IV), V, VI
System Description: LP 500 REDUCT
Repair System Description: LP 500 REDUCT
Maintenance Agreement Required: ☒ Yes ☐ No

☒ House/Mod. Home No. Bedrooms 3
☐ Mobile Home No. Bathrooms 3
☐ Business No. Employees
☐ Other
☐ Slab ☒ Crawl Space ☐ Basement w/plumbing ☐ Basement wo/plumbing

Water Supply: ☒ Individual ☐ Public ☐ Community WELL

Comments:/Conditions:

INITIAL SITE SKETCH

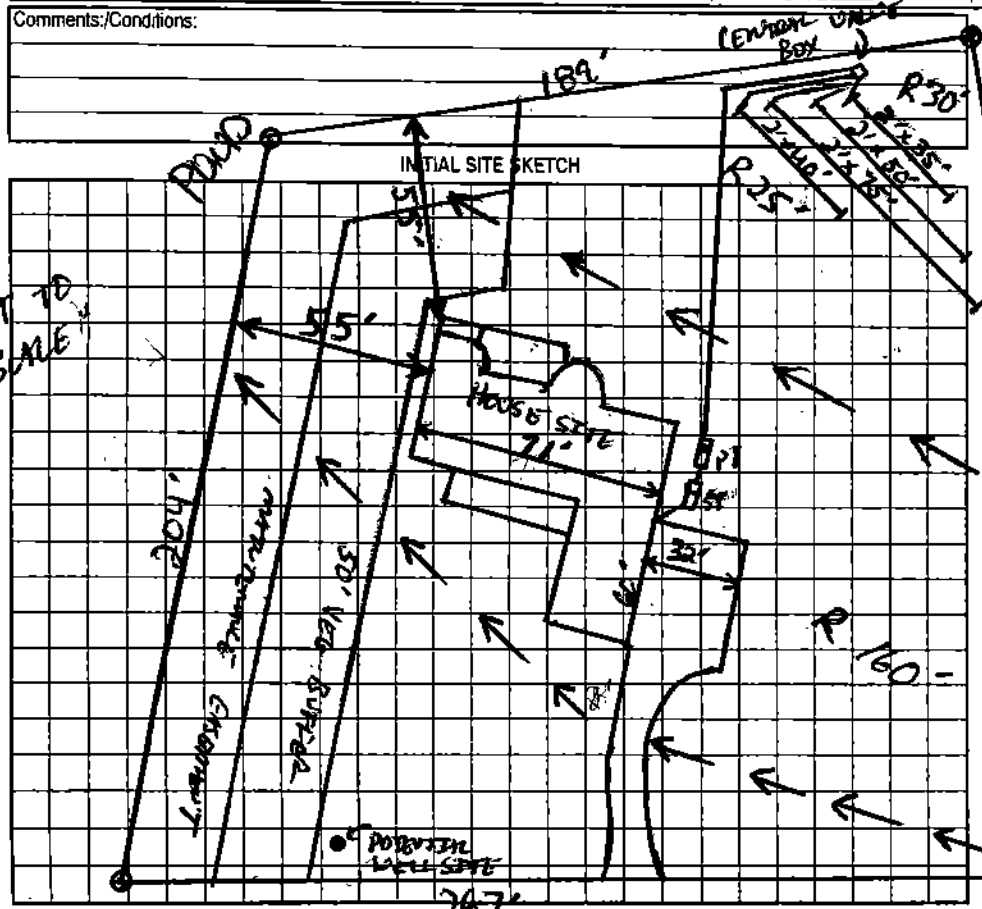

Comments:/Conditions: ① INSTALL LINES ON CONTOURS ② MAINTAIN SETBACKS ③ SYSTEM & HOUSE TO BE FLAGGED OUT COMPLETELY ④ L/O WAS Applied to DAVID HENSON, R.S., & L/O WAS supported.

AS BUILT SKETCH

R = REPAIR AREA

Approved A 3 BEDROOM 68' WIDE X 81' DEEP HOUSE. [redacted] HOUSE TOWARD RD 11' TO ADD 20 & ADD 10' TOWARD BACK TOTAL 30 & 81'. MAINTAIN SETBACKS LC 7-21-05

RED POLY LOK FILL / RIGERS. TALKED TO BUILDER & INSTALLER, ADD SURFACE DIVERSION BERM, NOT CUT DITCH, SOD TO Stabilize

H.U. Won't VOID REPAIR AREA BECAUSE CAN BE REMOVED.

Permit can be suspended or revoked if any false information is supplied toward securing the permit/any unauthorized changes are made to the site/any unauthorized changes are made in the installation of the system. Improvement Permit with plat valid without expiration. Improvement Permit with site plan valid for sixty months. Authorization to Construct is valid for a period equal to that of Improvement Permit – not to exceed sixty months.

Signed: [signature] date 6-6-05 Installed by: SAMMY REAVIS

Improvement Permit by: [signature] date 5-19-05 Operation Permit by: STEVE HEDRICK date 5-16-06

Authorization to Construct by: [signature] date 7-21-05 Existing System Inspection by: date

HEALTH DEPT. COPY: WHITE OWNER COPY (FINAL): YELLOW OWNER COPY (INITIAL): PINK