IREDELL COUNTY HEALTH DEPARTMENT

STATESVILLE 704-878-5305 MOORESVILLE 704-664-5281

IMPROVEMENT PERMIT / AUTHORIZATION TO CONSTRUCT / OPERATION PERMIT / EXISTING SYSTEM INSPECTION

PERMIT# 72242 PIN# 4711326122 DATE 9-17-98

OWNER OR CONTRACTOR Wayne Orme PHONE: Business 664 7416 Home

ADDRESS 180 Lanning circle Apt E Mooresville, N.C. 28115

LOCATION Buffalo Shoals Tl Laurel Cove TR Hubargate TR Haborwatch Corner Harbor Ridge

SUBDIVISION Haber Watch BLOCK / SECTION 4 LOT 77 LOT AREA 1.26acres SITE CLASS. PS DESIGN FLOW 480 L.T.A.R. .3

Septic Tank: 1000 Gallons; STB 1012 Date 8-24-99
Pump Tank: Gallons; PT Date
Pump Make: Model Serial No.
Nitrification Field: No Fields 1 Square Feet 1600 Linear Feet 533
No Lines 5 Trench Width 36" Max Trench Bottom Depth 36" Gravel Depth 12"

[X] New System [ ] Repair System Type: I, II, III, IV, V, VI
System Description: Conv. Gravity
Repair System Description: Pump To Type III
Maintenance Agreement Required: [ ] Yes [ ] No / 2570 ac

[X] House/Mod. Home No. Bedrooms 4
[ ] Mobile Home No. Bathrooms 2½
[ ] Business No. Employees
[ ] Other


[ ] Slab [X] Crawl Space [ ] Basement w/plumbing [ ] Basement wo/plumbing

Water Supply: [X] Individual [ ] Public [ ] Community


Comments:/Conditions:
Replaces Permit Issued 6-3-98 Lake Norman Properties

Comments:/Conditions:
House Position was changed

INITIAL SITE SKETCH

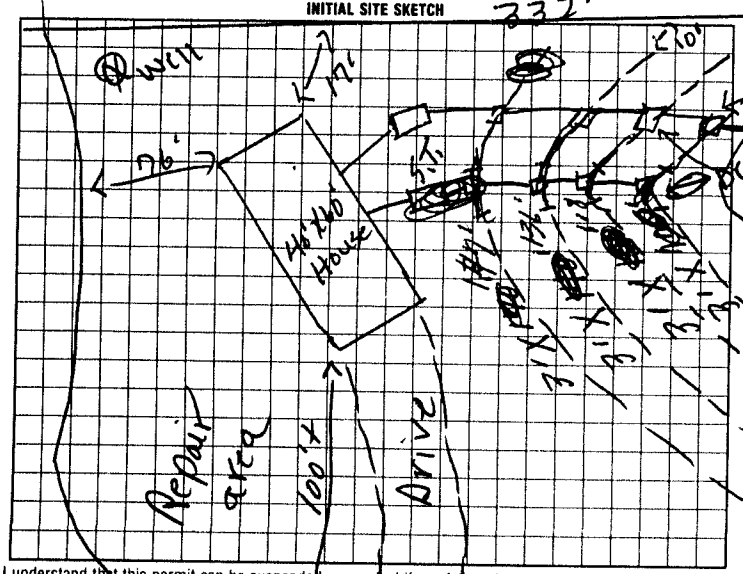

AS BUILT SKETCH

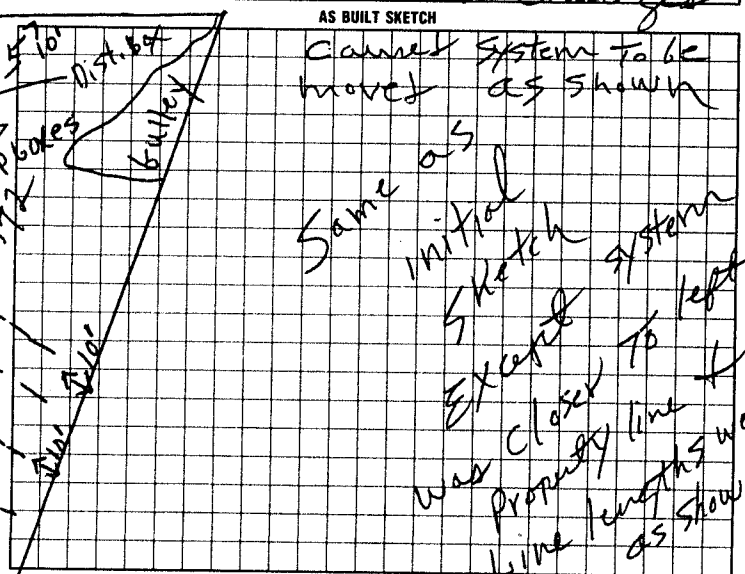

I understand that this permit can be suspended or revoked if any false information is supplied toward securing the permit/any unauthorized changes are made to the site/any unauthorized changes are made in the installation of the system. Improvement Permit with plat valid without expiration. Improvement Permit with site plan valid for sixty months. Authorization to Construct is valid for a period equal to that of Improvement Permit – not to exceed sixty months.

Signed: X Wayne Orme date

Improvement Permit by: F. C. Moore date 9-17-98

Authorization to Construct by: F. C. Moore date 9-17-98

Installed by: C & W Grading

Operation Permit by: F. C. Moore date 11-9-99

Existing System Inspection by: date

HEALTH DEPT. COPY. WHITE | INSPECTION COPY (FINAL) GREEN | OWNER COPY (FINAL) YELLOW | INSPECTION COPY (INITIAL) PINK | OWNER COPY (INITIAL). GOLD