3:00 CI

IREDELL COUNTY HEALTH DEPARTMENT

STATESVILLE 704-878-5305 MOORESVILLE 704-664-5281

IMPROVEMENT PERMIT / AUTHORIZATION TO CONSTRUCT / OPERATION PERMIT / EXISTING SYSTEM INSPECTION

PERMIT# 133928 PIN# 4711344171 DATE 3-20-06

OWNER OR APPLICANT John Kearey PHONE: Business 704 883 9811 Home

ADDRESS Harbor Watch Dr.

LOCATION Buffalo Shoals, left Laurel Cove, right Harbor Watch, right Harbor ~~Water~~ Ridge Dr., Property on right

SUBDIVISION Harbor Watch BLOCK / SECTION 4 LOT 76 LOT AREA 2.791 SITE CLASS: PS DESIGN FLOW 480 L.T.A.R. .25

Septic Tank: 1000 Gallons; STB 825 Date 7-20-05
Pump Tank: Gallons; PT Date
Pump Make: Model Serial No.
Nitrification Field: No Fields 1 Square Feet 1920 Linear Feet 480
No Lines 5 Trench Width 36" Max Trench Bottom Depth 36"

☒ New System ☐ Repair ☐ Expansion System Type: I (II) III IV V VI
System Description: 25% Reduction - Gravity
Repair System Description: 25% Reduction - Gravity
Maintenance Agreement Required: ☐ Yes ☒ No

☒ House/Mod. Home No. Bedrooms 4
☐ Mobile Home No. Persons
☐ Business No. Employees
☐ Other


Water Supply: ☒ Individual ☐ Public ☐ Community

Gravel Depth n/a ☒ Gravity ☐ Pressure ☐ Slab ☒ Crawl Space ☐ Basement w/plumbing ☐ Basement wo/plumbing

Comments:/Conditions:
Pool ≥ 15' from septic tank
tank ≥ 15' from house

Comments:/Conditions:
Blue Polyloch

INITIAL SITE SKETCH

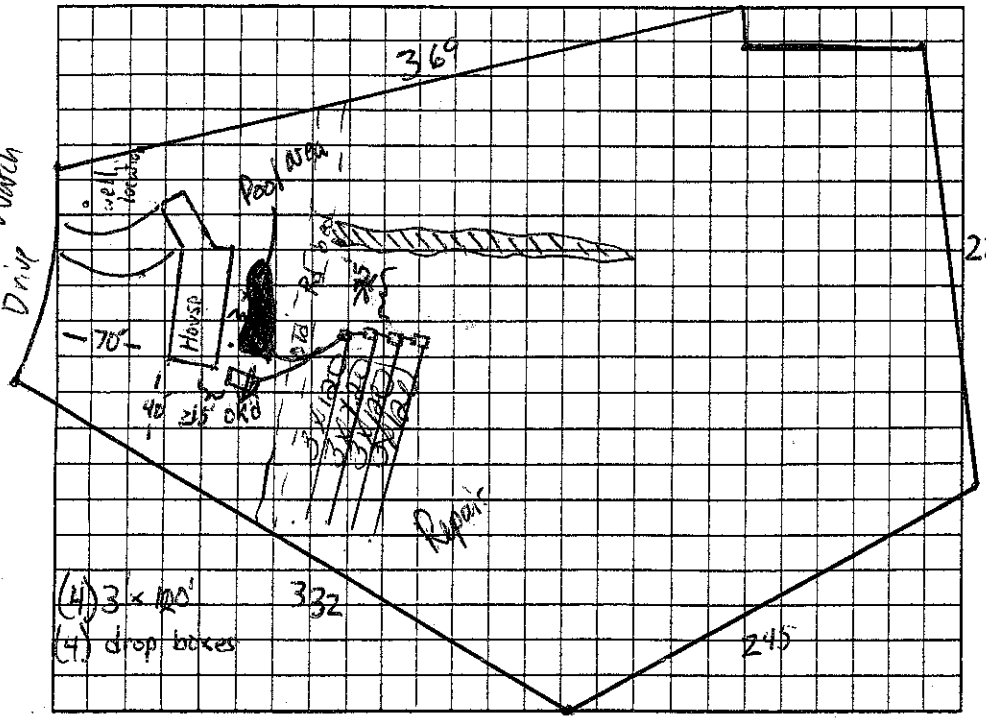

AS BUILT SKETCH

Permit can be suspended or revoked if any false information is supplied toward securing the permit/any unauthorized changes are made to the site/any unauthorized changes are made in the installation of the system. Improvement Permit with plat valid without expiration ☐ Improvement Permit with site plan valid for sixty months ☐ Authorization to Construct is valid for a period equal to that of Improvement Permit – not to exceed sixty months.

Signed: Marika Kearey date 5-22-06 Installed by: Brown Septic

Improvement Permit by: James Allen date 3-20-06 Operation Permit by: Doug Cook date 8-29-06

Authorization to Construct by: James Allen date 4-3-06 Existing System Inspection by: date

HEALTH DEPT. COPY: WHITE OWNER COPY (FINAL): YELLOW OWNER COPY (INITIAL): PINK