IREDELL COUNTY HEALTH DEPARTMENT

STATESVILLE 704-878-5305 MOORESVILLE 704-664-5281

IMPROVEMENT PERMIT / CERTIFICATE OF COMPLETION / OPERATION PERMIT / EXISTING SYSTEM INSPECTION

PROPERTY DESCRIPTION NO. 065770 DATE 4-16-97 TAX MAP NO. 3Q-A-8 (4711365654) Watershed JLCA (N) No

OWNER OR CONTRACTOR ERIC McDANIELS PHONE: Business Home 872-7226

ADDRESS 490 MASSEY DEAL, STATESVILLE, NC 28677

LOCATION I-40 W, TL OLD MOUNTAIN ROAD, TR BUFFALO SHOALS ROAD, 3.1 MILES ON RIGHT

SUBDIVISION BLOCK / SECTION LOT 18 LOT AREA 1.0 ACRE SITE CLASS. PS DESIGN FLOW 360 L.T.A.R. 0.30 GPD/FT²

Septic Tank: 1000 Gallons; STB 1012 Date 5-19-97

Pump Tank: Gallons; PT Date

Pump Make: Model Serial No.

Nitrification Field: No Fields 1 Square Feet 1200 Linear Feet 400

No Lines FIVE Trench Width 36" Max Trench Bottom Depth 30

☑ New System ☐ Repair System Type: I, II, III, IV, V, VI

System Description: CONVENTIONAL GRAVITY

Repair System Description: CONVENTIONAL, PUMP

Maintenance Agreement Required: ☐ Yes ☑ No

Gravel Depth 12

☐ House/Mod. Home No. Bedrooms 3

☑ Mobile Home No. Bathrooms 2

☐ Business No. Employees

☐ Other

☐ Slab ☑ Crawl Space ☐ Basement w/plumbing ☐ Basement wo/plumbing


Water Supply: ☑ Individual ☐ Community ☒ Public

Comments: KEEP SYSTEM MAXIMUM FEASIBLE DISTANCE FROM WELL (≥100') ② CONTACT HEALTH DEPT. PRIOR TO INSTALLATION TO FLAG OUT SYSTEM.

Comments:

INITIAL SITE SKETCH

SCALE: 1"=50'

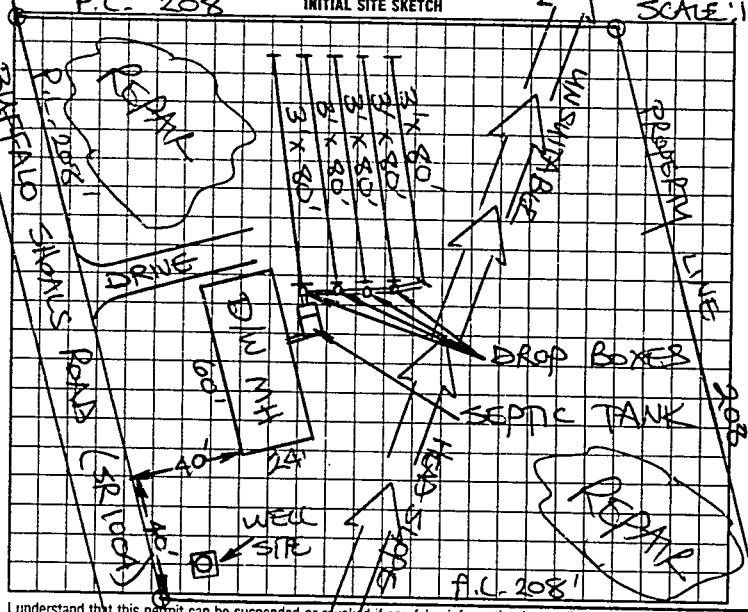

AS BUILT SKETCH

Installed as shown

I understand that this permit can be suspended or revoked if any false information is supplied toward securing the permit any unauthorized changes are made to the site/any unauthorized changes are made in the installation of the system. Improvement Permit is valid for 60 months from date of issuance. AUTHORIZATION TO CONSTRUCT IS VALID FOR 60 MONTHS FROM DATE OF ISSUANCE.

Signed:

Improvement Permit by: STEVE HEDRICK date 6-19-97

~~Auth. To Const.~~ ~~Existing System Inspection~~ by: STEVE HEDRICK date 6-19-97

Installed by: Donald Lackey

~~Certificate of Completion by:~~ date

Operation Permit by: Mark C Ort RS date 7-29-97

HEALTH DEPT. COPY WHITE | INSPECTION COPY (FINAL) GREEN | OWNER COPY (FINAL) YELLOW | INSPECTION COPY (INITIAL) PINK | OWNER COPY (INITIAL) GOLD