IREDELL COUNTY HEALTH DEPARTMENT

STATESVILLE 704-878-5305 MOORESVILLE 704-664-5281

IMPROVEMENT PERMIT / CERTIFICATE OF COMPLETION / OPERATION PERMIT / EXISTING SYSTEM INSPECTION

PROPERTY DESCRIPTION NO. 22679 067849 DATE 5-21-97

OWNER OR CONTRACTOR Billy Jarrett Jr. TAX MAP NO. 3Q-A-54

ADDRESS 940 27th St. NE Conover N.C. PHONE: Business ______ Home 256 5524

Watershed: ☑ Yes ☐ No WSIV PA

LOCATION Buffalo Shoals Turn Troutman Shoals TL Cass Catton 3rd mH left

SUBDIVISION ______ BLOCK / SECTION ______ LOT ______ LOT AREA 1.32 acres SITE CLASS. PS DESIGN FLOW 480 L.T.A.R. .35

Septic Tank: 1000 Gallons; STB 794 Date 4-17-97

Pump Tank: ______ Gallons; PT ______ Date ______

Pump Make: ______ Model ______ Serial No. ______

Nitrification Field: No Fields 1 Square Feet 1380 Linear Feet 460

No Lines 5 Trench Width 36" Max Trench Bottom Depth 36" Gravel Depth 12"

☑ New System ☐ Repair System Type: I, ⓘ, III, IV, V, VI

System Description: Conv. Gravity

Repair System Description: " "

Maintenance Agreement Required: ☐ Yes ☑ No

☐ Slab ☑ Crawl Space ☐ Basement w/plumbing ☐ Basement wo/plumbing

☐ House/Mod. Home ☑ Mobile Home ☐ Business ☐ Other ______


No. Bedrooms 4 No. Bathrooms 2 No. Employees ______

Water Supply: ☑ Individual ☐ Community ☐ Public


Comments:

Comments:

INITIAL SITE SKETCH

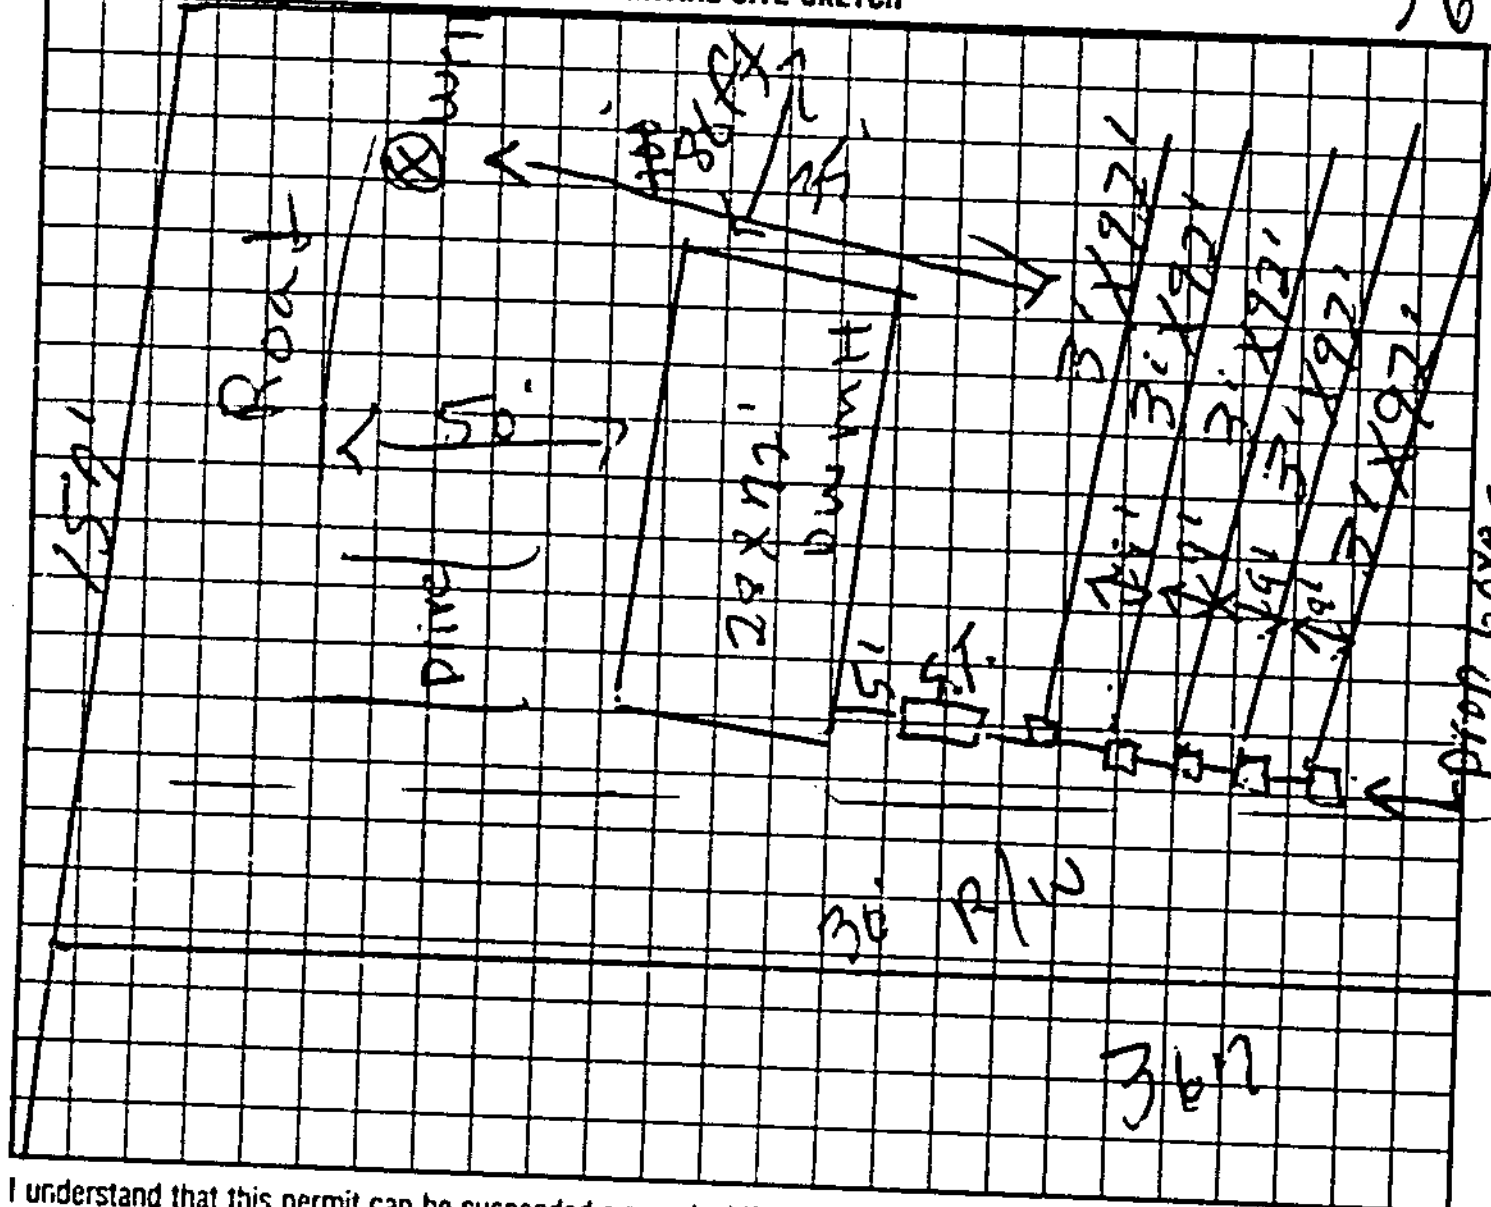

AS BUILT SKETCH

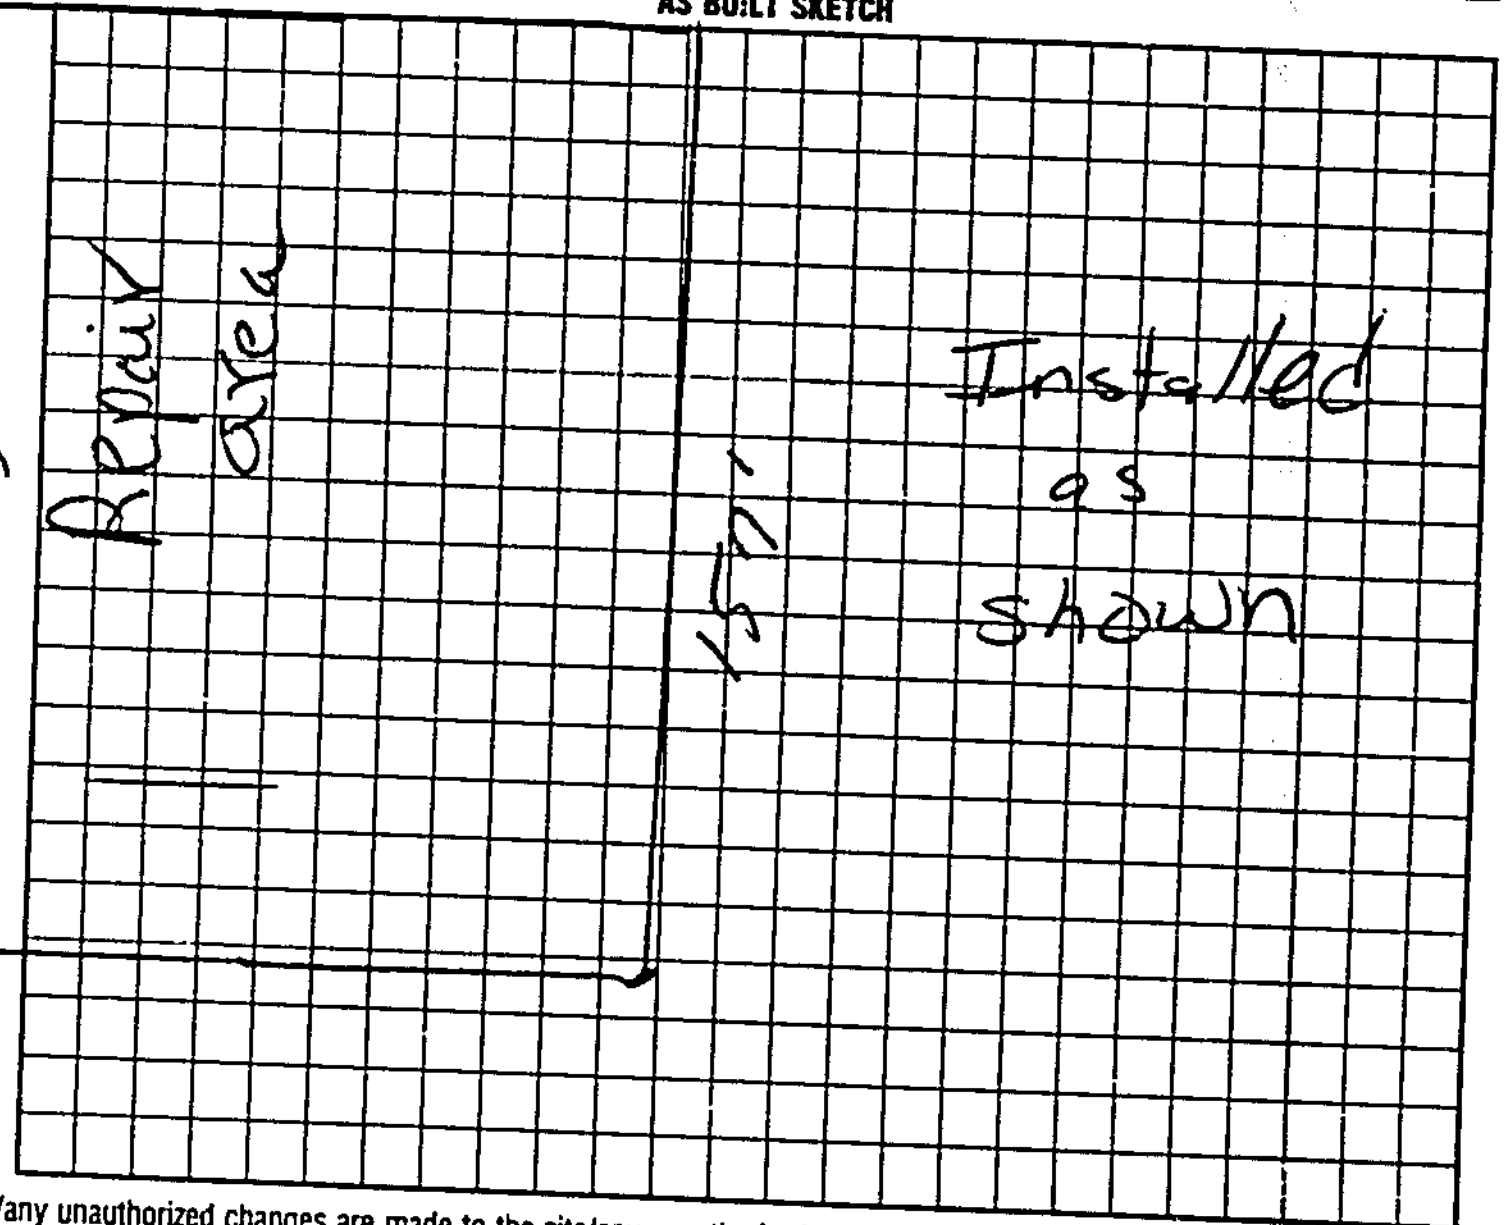

I understand that this permit can be suspended or revoked if any false information is supplied toward securing the permit/any unauthorized changes are made to the site/any unauthorized changes are made in the installation of the system. Improvement Permit is valid for 60 months from date of issuance.

Signed: Billy Joe Jarrett Jr.

Improvement Permit by: B. C. Moore date 5-21-97

Authorization to Court.

Existing System Inspection by: B. C. Moore date 5-21-97

Installed by: Don Innes - BJR Construction

Certificate of Completion by: ______ date ______

Operation Permit by: Mat COARS date 7-22-97

HEALTH DEPT. COPY: WHITE INSPECTION COPY (FINAL): GREEN OWNER COPY (FINAL): YELLOW INSPECTION COPY (INITIAL): PINK OWNER COPY (INITIAL): GOLD

Authorization to court expires 60 mos from issue