IREDELL COUNTY HEALTH DEPARTMENT

Statesville Office (704) 878-5305 Mooresville Office (704) 660-3625 PERMIT # 203509 HP

IMPROVEMENT PERMIT / AUTHORIZATION TO CONSTRUCT / OPERATION PERMIT / EXISTING SYSTEM PIN # 4711384950

APPLICANT: Ronald W. Karriker APPLICANT ADDRESS: 226 Troutman Shoals Rd Statesville NC 28677

SITE ADDRESS: 226 Troutman Shoals Rd Statesville NC 28677 PHONE: 704-437-7507 ALT. PHONE: N/A


SITE DIRECTIONS: 115 to old Mocksville to Buffalo Shoals T/L on Troutman Shoals Lot at end on left

SUBDIVISION: N/A SECTION: N/A LOT # N/A LOT AREA: 1.803ac DESIGN FLOW: 240 L.T.A.R.: EX


Septic Tank	EX	(gal)	STB		Date		☐ New System	☐ Repair	☐ Expansion	System Type: I	II	III IV V VI	☒ Residence	No. Bedrooms	2	Water Supply
Pump Tank		(gal)	PT		Date		System Description:	Existing					☐ Business	No. Persons	4	☒ Private
Pump Make			Model		Serial #		Repair System Description:						☐ Other	No. Employees		☐ Public
# Nitrification Fields	1	# Lines	EX	Linear Ft:	EX		Maintenance Agreement Required:	☐ YES	☒ NO				☐ Slab	☒ Crawl Space		☐ Community
Trench Width	EX	Max. Trench Bottom Depth		EX	Gravel Depth	EX		☒ GRAVITY	☐ PRESSURE				☐ Basement w/plumbing		☐ Basement w/o plumbing	

Comments / Conditions: All building foundations must be 35' From any part of STS and 25' From any well.

INITIAL SITE SKETCH

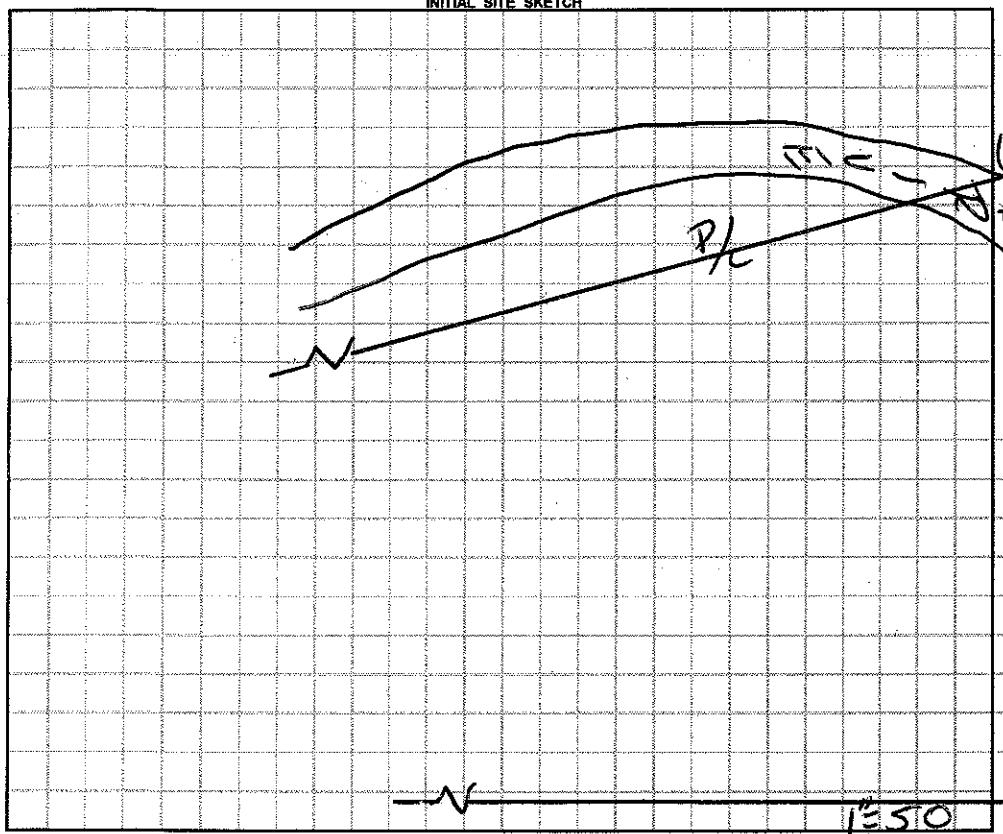

AS BUILT SKETCH

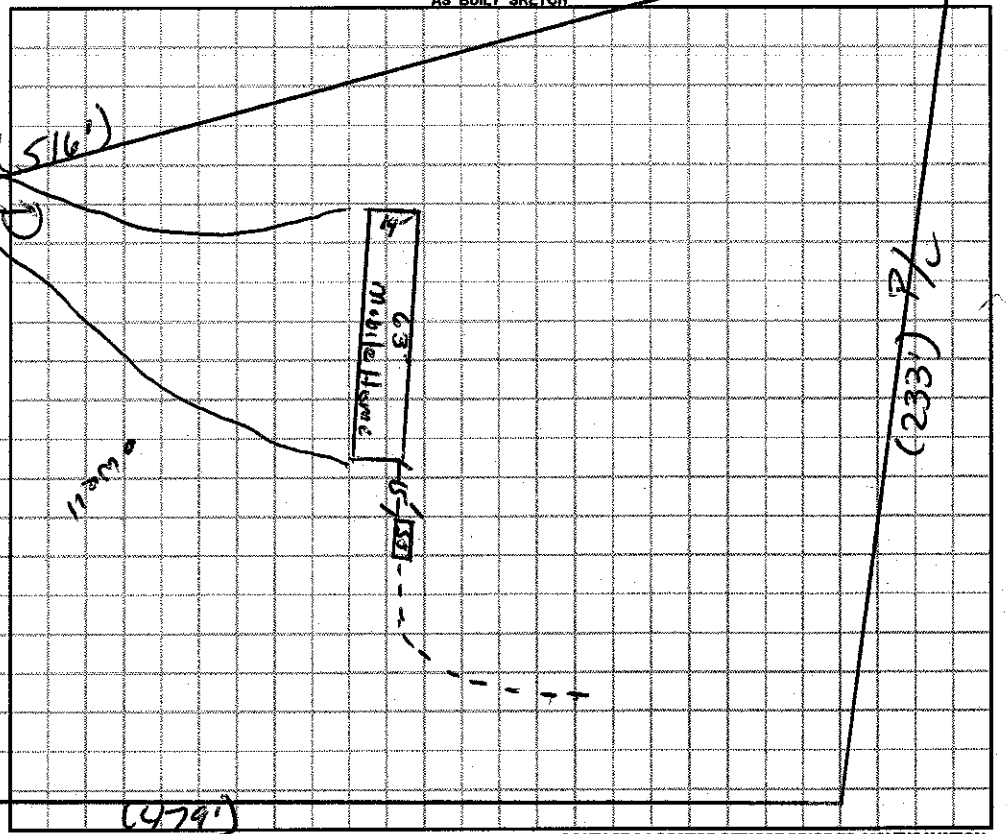

Permit can be suspended or revoked if any false information is supplied toward securing the permit / any unauthorized changes are made to the site / any unauthorized changes are made in the installation of the system. **CONTACT A LOCATOR SERVICE PRIOR TO ANY EXCAVATION**

☐ **IMPROVEMENT PERMIT** *with plat valid without expiration.* ☐ **IMPROVEMENT PERMIT** *with site plan valid for 60 mos.* ☐ **AUTHORIZATION TO CONSTRUCT** *valid for period equal to IMPROVEMENT PERMIT--not to exceed 60 mo.*

Owner / Applicant Signature: Ronald W Karriker Date: 5-23-14 Installed by:

IMPROVEMENT PERMIT by: Date: OPERATION PERMIT by: Date:

AUTHORIZATION TO CONSTRUCT by: Date: Existing System Inspected by: Date: 05/21/14

Health Dept. Copy - WHITE Applicant (Final Approval) - YELLOW Applicant (Conditional Approval) - PINK