Voids Previous DATed Permits

REDELL COUNTY HEALTH DEPARTMENT

STATESVILLE 704-878-5305 MOORESVILLE 704-664-5281

IMPROVEMENT PERMIT / AUTHORIZATION TO CONSTRUCT / OPERATION PERMIT / EXISTING SYSTEM INSPECTION

PERMIT# 68369 PIN# 4711315839 DATE June 29.2000

OWNER OR CONTRACTOR James Scott Ross PHONE: Business Home 528-2147

ADDRESS

LOCATION Old MT Rd ST (R) Buffalo Shoals (L) Laurel Cove (R) Harbor Gate (L) Lot on Left before High Lake

SUBDIVISION Harbor Watch BLOCK / SECTION II LOT 56 LOT AREA 1.0 Ac SITE CLASS PS DESIGN FLOW 480 L.T.A.R. .3

Septic Tank: 1000 Gallons; STB 312 Date 5-28-00
Pump Tank: Gallons; PT Date
Pump Make: Model Serial No.
Nitrification Field: No. Fields 1 Square Feet 1600 Lineal Feet 400
No. Lines 4 Five Trench Width 36" Max Trench Bottom Depth 36"

(X) New System ( ) Repair System Type: I. II. (III) IV. V. VI
System Description: GRAVITY 25% Reduction
Repair System Description: 50% Reduction Pump
Maintenance Agreement Required: ( ) Yes (X) No Poss. bla
Gravel Depth N/A

(X) House/Mod. Home No. Bedrooms 4
( ) Mobile Home No. Bathrooms 2
( ) Business No. Employees
( ) Other

( ) Slab (X) Crawl Space ( ) Basement w/plumbing ( ) Basement wo/plumbing


Water Supply: (X) Individual ( ) Public ( ) Community WELL

Comments/Conditions: INSTALL on CONTOUR
GUTTER DRAINS MUST be DIVERTED AWAY From SEPTIC Field before O.P. Issued
~~LOT Number~~ *40 HDS Sections To be used due To CONTOUR
Inspection PORTS on EACH Line ~~Shall~~ extend Flush w/ Ground SURFACE


Comments/Conditions: ②SYSTEM ALTERED AS SHOWN BELOW WITHOUT PRIOR HEALTH DEPT. APPROVAL

Not To Scale

INITIAL SITE SKETCH

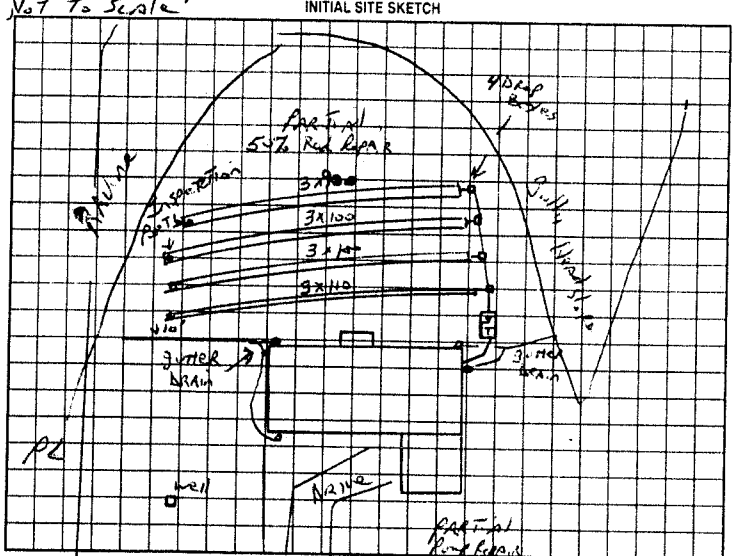

AS BUILT SKETCH

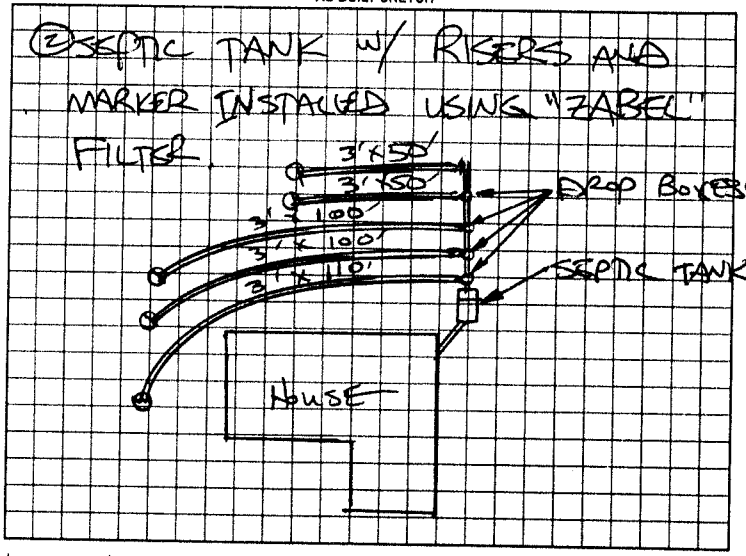

Permit can be suspended or revoked if any false information is supplied toward securing the permit/any unauthorized changes are made to the site/any unauthorized changes are made in the installation of the system. Improvement Permit with plat valid without expiration. Improvement Permit with site plan valid for sixty months. Authorization to Construct is valid for a period equal to that of Improvement Permit – not to exceed sixty months.

Signed: Ginger Ross date June 29 2000 Installed by: Eskert Elder

Improvement Permit by: J.C. Potter date June 29 2000 Operation Permit by: J.C. Potter date July 4 2000

Authorization to Construct by: J.C. Potter date June 29 2000 Existing System Inspection by: date

HEALTH DEPT COPY: WHITE OWNER COPY (FINAL): YELLOW OWNER COPY (INITIAL): PINK