IREDELL COUNTY HEALTH DEPARTMENT

STATESVILLE 704-878-5305 MOORESVILLE 704-664-5281

IMPROVEMENT PERMIT / AUTHORIZATION TO CONSTRUCT / OPERATION PERMIT / EXISTING SYSTEM INSPECTION

PERMIT# 113592 PIN# 4711-41-2076 DATE 7/7/03

OWNER OR CONTRACTOR Gerald Fregeolle PHONE: Business — Home (704)528-3344

ADDRESS 249 Spring Meadows Lane Statesville N.C. 28677

LOCATION Buffalo Shoals, (L) Laurel Cove (R) Harbor Watch S/D, (L) on Harbor Watch 4th on Left.

SUBDIVISION Harbor Watch BLOCK / SECTION II LOT #53 LOT AREA 1.29 Acres SITE CLASS. 1&5 DESIGN FLOW 360 L.T.A.R. .30 g pd/sqft

Septic Tank: 1000 Gallons; STB 1007 Date 10-8-03

Pump Tank: — Gallons; PT — Date —

Pump Make: — Model — Serial No. —

Nitrification Field: No Fields 1 Square Feet Equ to 1200 Linear Feet 300

No Lines 3 Trench Width 36" Max Trench Bottom Depth 36" Gravel Depth N/A

☒ New System ☐ Repair System Type: I, II, III, IV, V, VI

System Description: Gravity, 25% Reduction

Repair System Description: Gravity, 25% Reduction

Maintenance Agreement Required: ☐ Yes ☒ No

☒ House/Mod. Home ☐ Mobile Home ☐ Business ☐ Other

No. Bedrooms 3 No. Bathrooms 2 No. Employees —

☐ Slab ☒ Crawl Space ☐ Basement w/plumbing ☐ Basement wo/plumbing

Water Supply: ☒ Individual ☐ Public ☐ Community


Comments:/Conditions: ① Keep lines 100 ft from well ② Install lines on contour

Comments:/Conditions:


Tuff-Tite Filter + S.Tank Marker Installed

- 48 In. Water Chambers Installed

INITIAL SITE SKETCH

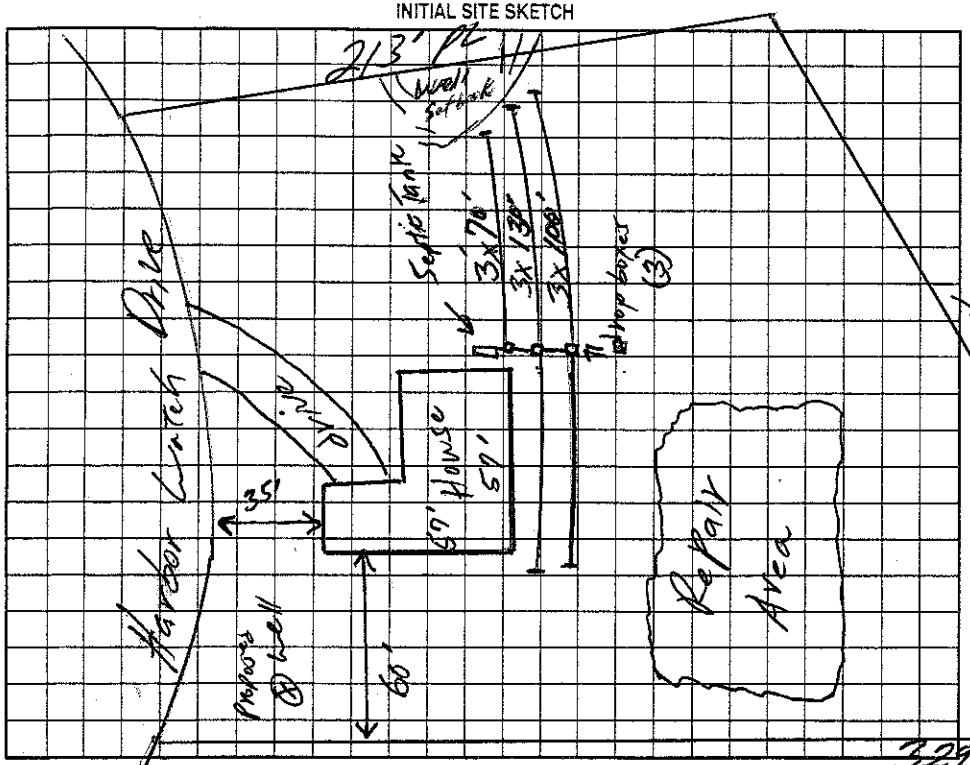

AS BUILT SKETCH

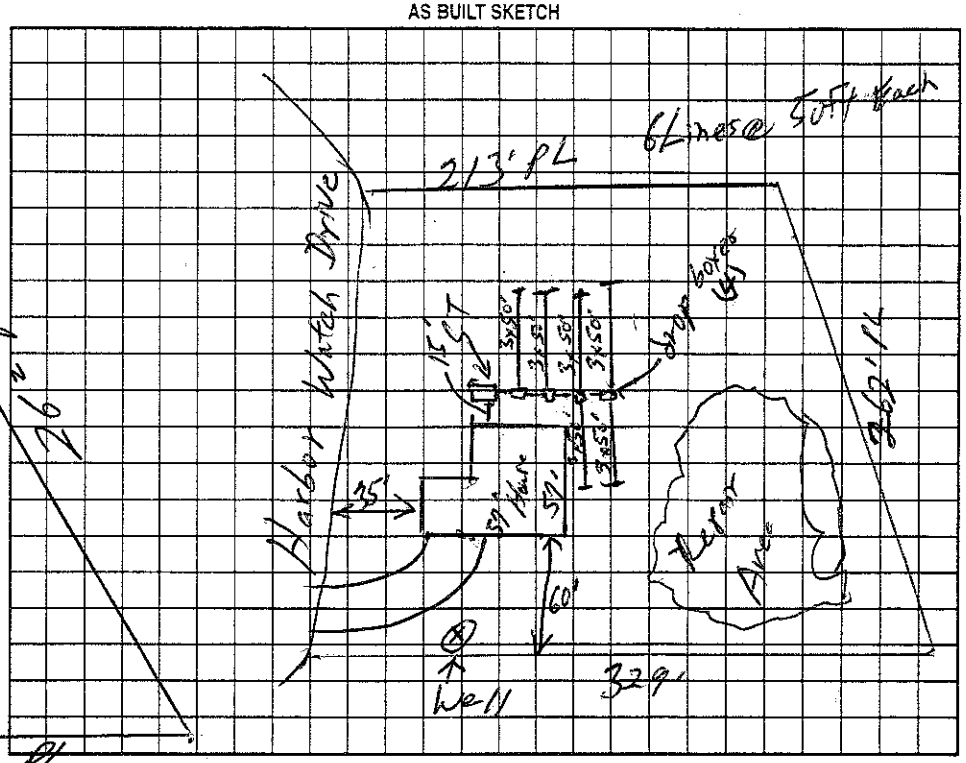

Permit can be suspended or revoked if any false information is supplied toward securing the permit/any unauthorized changes are made to the site/any unauthorized changes are made in the installation of the system. Improvement Permit with plat valid without expiration. Improvement Permit with site plan valid for sixty months. Authorization to Construct is valid for a period equal to that of Improvement Permit – not to exceed sixty months.

Signed: Phyllis P. Fregeolle date —

Improvement Permit by: William O. Johnson date 7/7/03

Authorization to Construct by: William O. Johnson date 7/7/03

Installed by: Sammy Shoemaker

Operation Permit by: William O. Johnson date 11/25/03

Existing System Inspection by: — date —

HEALTH DEPT. COPY: WHITE OWNER COPY (FINAL): YELLOW OWNER COPY (INITIAL): PINK