Paid 275.00 OK

IREDELL COUNTY HEALTH DEPARTMENT

STATESVILLE 704-878-5305 MOORESVILLE 704-664-5281

IMPROVEMENT PERMIT / AUTHORIZATION TO CONSTRUCT / OPERATION PERMIT / EXISTING SYSTEM INSPECTION

PERMIT# 068546 PIN# 4711358839 DATE August 23, 00

OWNER OR CONTRACTOR David Ring // Golden Rule Builders PHONE: Business 201-0485 Home

ADDRESS PO Box 2018 Davidson NC 28036

LOCATION Buffalo Shoals Rd. TL Laurel Cove TR Harborgate TL Harborwatch 1 lot on left

SUBDIVISION Harborwatch BLOCK / SECTION II LOT 59 LOT AREA .96 Acs SITE CLASS PS DESIGN FLOW 360gpd L.T.A.R. .3

Septic Tank: 1000 Gallons; STB 760 Date 7-16-01

Pump Tank: 1000 Gallons; PT 188 Date 10-13-01

Pump Make: Hydromatic Model SHEF 40 A1 Serial No.

Nitrification Field: No Fields Square Feet 900 Linear Feet 300

No Lines 5@60' Trench Width 36" Max Trench Bottom Depth 36" Gravel Depth N/A

☑ New System ☐ Repair System Type: I II III IV V VI

System Description: PM - Innovative - 25% Reduction

Repair System Description: Same

Maintenance Agreement Required: ☐ Yes ☑ No

☑ House/Mod. Home No. Bedrooms 3

☐ Mobile Home No. Bathrooms 3

☐ Business No. Employees

☐ Other

☐ Slab ☐ Crawl Space ☑ Basement w/plumbing ☐ Basement wo/plumbing

Water Supply: ☑ Individual ☐ Public ☐ Community

Comments/Conditions: THIS PERMIT WAS PREVIOUS ISSUED 11-7-01 (PERMIT)


1" = 50'

250.01

Comments/Conditions

DRAINLINES INSPECTED 12-7-01 - 48 "INFILTRATOR" CHAMBERS INSTALLED

INITIAL SITE SKETCH

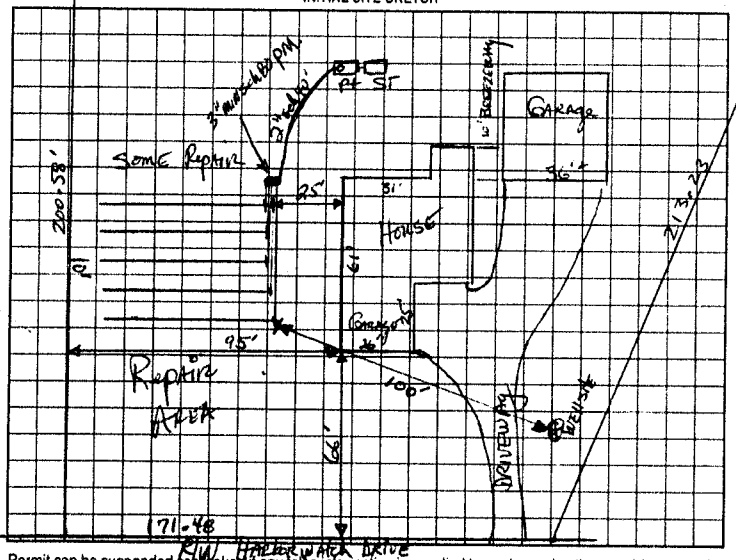

AS BUILT SKETCH

SYSTEM INSTALLED ACCORDING TO INITIAL SITE SKETCH

Permit can be suspended or revoked if any false information is supplied toward securing the permit/any unauthorized changes are made to the site/any unauthorized changes are made in the installation of the system. Improvement Permit with plat valid without expiration. Improvement Permit with site plan valid for sixty months. Authorization to Construct is valid for a period equal to that of Improvement Permit – not to exceed sixty months.

Signed: [signature] date 8-23-00

Improvement Permit by: [signature], RS date 8-23-00

Authorization to Construct by: [signature], RS date 8-23-00

Installed by: BARRY SIGMON

Operation Permit by: STEVE HEDRICK date 4-3-02

Existing System Inspection by: date

HEALTH DEPT. COPY WHITE OWNER COPY (FINAL) YELLOW OWNER COPY (INITIAL) PINK