IREDELL COUNTY HEALTH DEPARTMENT

STATESVILLE 704-878-5305 AI MOORESVILLE 704-664-5281

IMPROVEMENT PERMIT / AUTHORIZATION TO CONSTRUCT / OPERATION PERMIT / EXISTING SYSTEM INSPECTION

PERMIT# 117649 PIN# 4711-42-2983 DATE 1/13/04

OWNER OR CONTRACTOR P.S. Rushing Inc PHONE: Business (704) 896-5766 Home

ADDRESS 221 Bexacal Rd Mooresville, N.C. 28115

LOCATION Buffalo Shoals Rd, (L) Laurel Cove Rd, (R) Harbor Gate, (R) Harbor Watch Dr, 5th lot on Right

SUBDIVISION Harbor Watch BLOCK / SECTION III LOT 83 LOT AREA 2.96 A. SITE CLASS. PS DESIGN FLOW 480 L.T.A.R. .025 gpd

Septic Tank: 4000 Gallons; STB 794 Date 3-5-04
Pump Tank: Gallons; PT Date
Pump Make: Model Eq to Serial No.
Nitrification Field: No Fields 1 Square Feet 1600 Linear Feet 480'
No Lines 4@120' Trench Width 36" Max Trench Bottom Depth 30" Gravel Depth N/A

☒ New System ☐ Repair System Type: I, II, (III) IV, V, VI
System Description: Gravity, 25% Reduction
Repair System Description: Gravity, 50% Red
Maintenance Agreement Required: ☐ Yes ☒ No


☒ House/Mod. Home ☐ Mobile Home ☐ Business ☐ Other
No. Bedrooms 4 No. Bathrooms 3.5 No. Employees
☐ Slab ☐ Crawl Space ☐ Basement w/plumbing ☒ Basement wo/plumbing

Water Supply: ☒ Individual ☐ Public ☐ Community


Comments:/Conditions: (1) Install Lines on contour (2) Maintain proper Setbacks

Comments:/Conditions: - Red poly lok fitter Installed w/ST mortar - 4ea - 10ft sections of EZ Lay

INITIAL SITE SKETCH

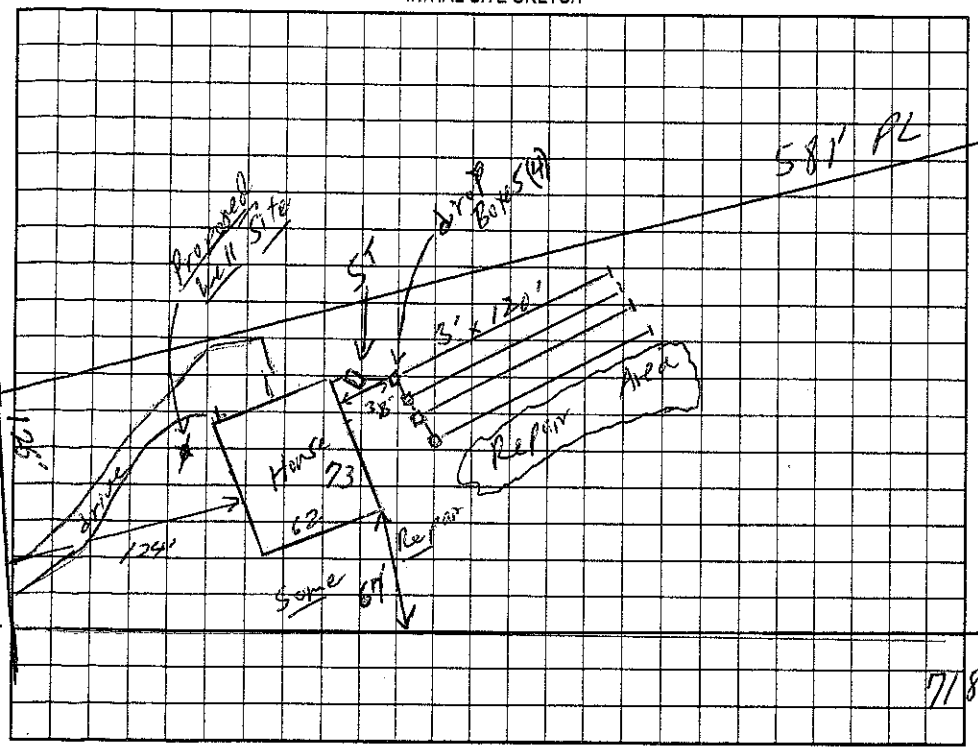

AS BUILT SKETCH

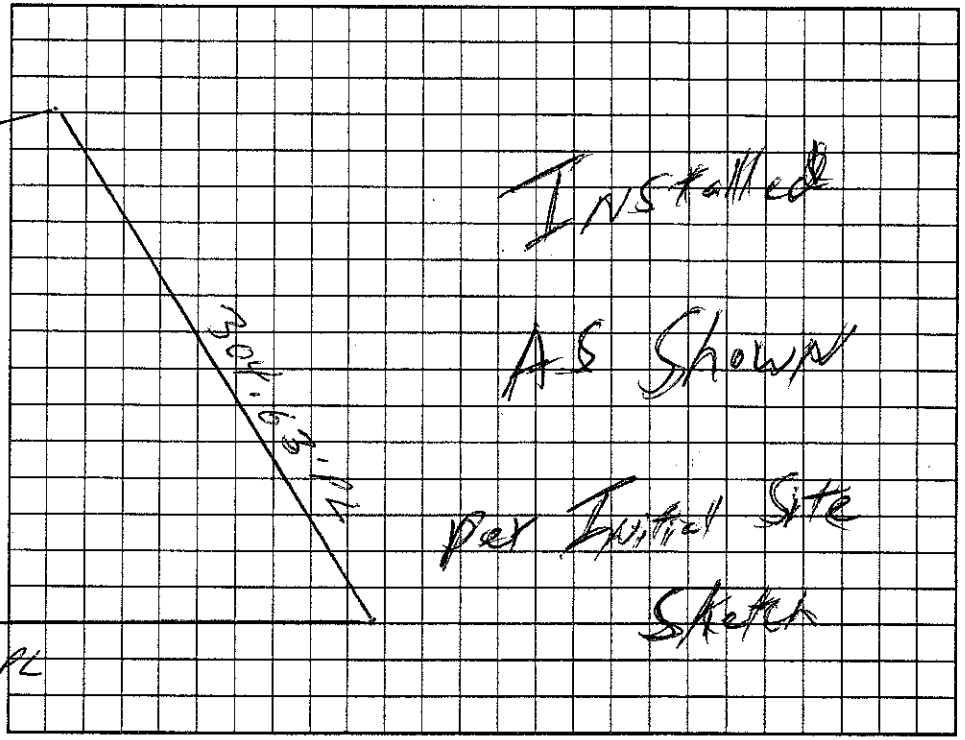

Permit can be suspended or revoked if any false information is supplied toward securing the permit/any unauthorized changes are made to the site/any unauthorized changes are made in the installation of the system. Improvement Permit with plat valid without expiration. Improvement Permit with site plan valid for sixty months. Authorization to Construct is valid for a period equal to that of Improvement Permit – not to exceed sixty months.

Signed: David Rushing date 1-14-03 Installed by: Bobby McGraver

Improvement Permit by: William O. Johnson date 1/13/04 Operation Permit by: William O. Johnson date 6/10/04

Authorization to Construct by: William O. Johnson date 1/13/04 Existing System Inspection by: date

HEALTH DEPT. COPY: WHITE OWNER COPY (FINAL): YELLOW OWNER COPY (INITIAL): PINK