IREDELL COUNTY HEALTH DEPARTMENT

THIS PERMIT VOIDS PREVIOUS ISSUED 8-28-03

STATESVILLE 704-878-5305 MOORESVILLE 704-664-5281

IMPROVEMENT PERMIT / AUTHORIZATION TO CONSTRUCT / OPERATION PERMIT / EXISTING SYSTEM INSPECTION

PERMIT# 113932 PIN# 4711-43-1111 DATE 7-13-04

OWNER OR CONTRACTOR STEVEN TURLEY PHONE: Business 704-664-4400 Home 704-309-0762

ADDRESS P.O. BOX 4025, MOORESVILLE NC 28117

LOCATION BUFFALO SHOALS ROAD, TL LAUREL COVE ROAD TR HARBORGATE TR HARBORWATCH DR, 6TH LOT ON RIGHT

SUBDIVISION HARBOR WATCH BLOCK / SECTION IV LOT 82 LOT AREA 3.247 ACRES SITE CLASS. 'P-S' DESIGN FLOW 360 L.T.A.R. 0.30GPD/FT²

Septic Tank: 1000 Gallons; STB 794 Date 3-14-04

Pump Tank: _____ Gallons; PT _____ Date _____

Pump Make: _____ Model _____ Serial No. _____

Nitrification Field: No Fields 1 Square Feet EXP 1200 Linear Feet 300

No Lines FIVE Trench Width 36" Max Trench Bottom Depth 36" Gravel Depth N/A

☑ New System ☐ Repair System Type: I, II, III, IV, V, VI

System Description: 25% REDUCTION, GRAVITY

Repair System Description: 25% REDUCTION, PUMP

Maintenance Agreement Required: ☐ Yes ☑ No

☑ House/Mod. Home No. Bedrooms 3

☐ Mobile Home No. Bathrooms 4

☐ Business No. Employees ____

☐ Other ____


☐ Slab ☐ Crawl Space ☑ Basement w/plumbing ☐ Basement wo/plumbing

Water Supply: ☑ Individual ☐ Public ☐ Community WELL


Comments/Conditions: INSTALL 25% REDUCTION SYSTEM AT LOCATION SHOWN & FLAGGED ON SITE.

Comments/Conditions: POLYLOK FILTER & MARVER/RISERS INSTALLED AS DRAWN

INITIAL SITE SKETCH

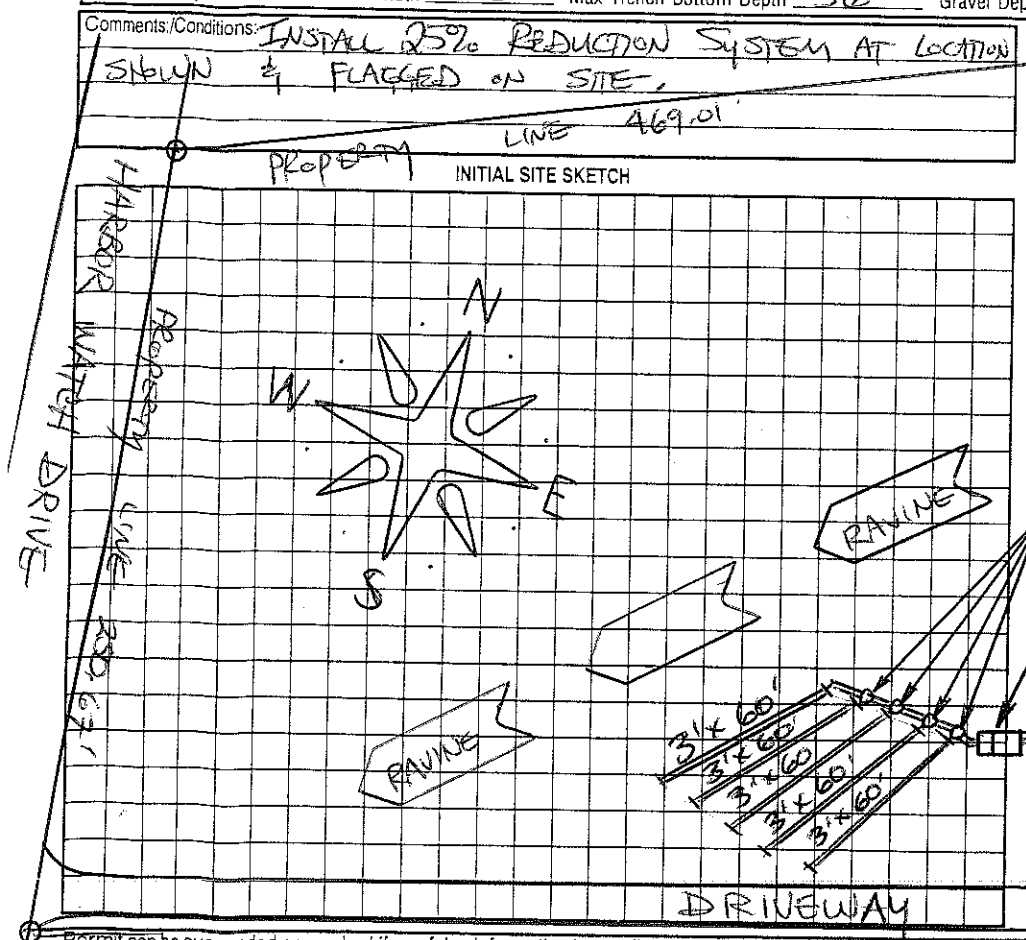

AS BUILT SKETCH

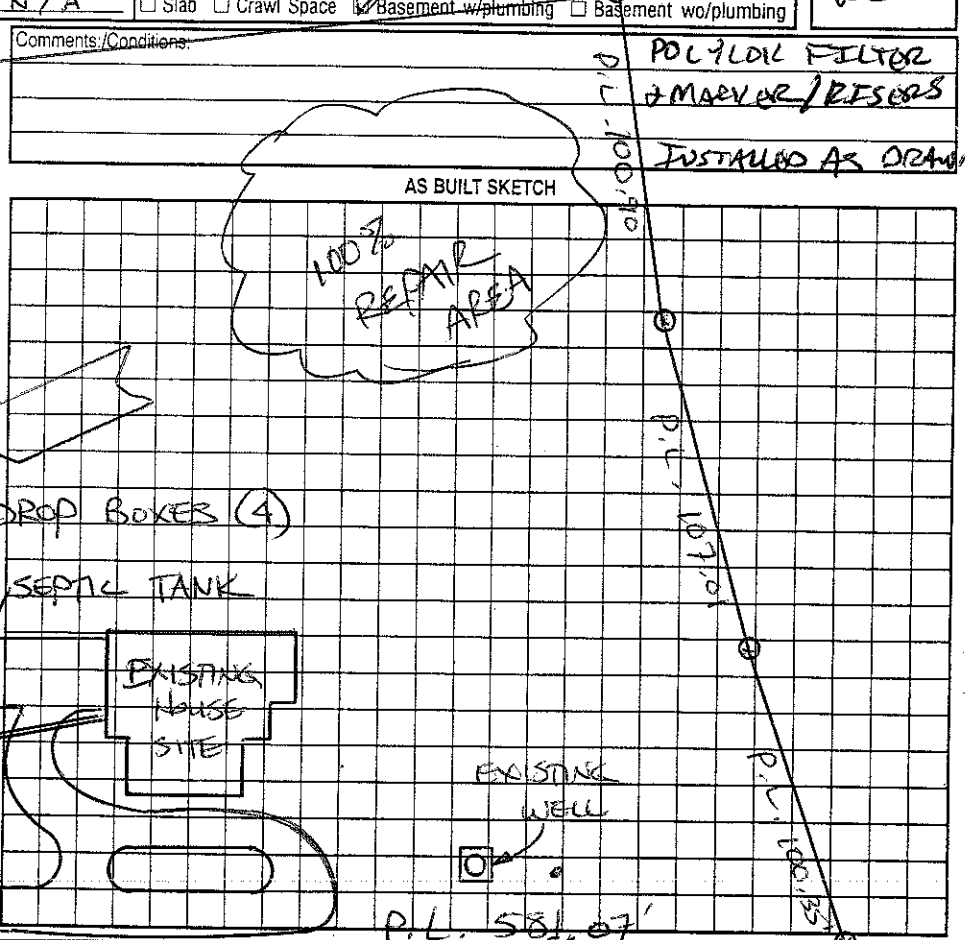

Permit can be suspended or revoked if any false information is supplied toward securing the permit/any unauthorized changes are made to the site/any unauthorized changes are made in the installation of the system. Improvement Permit with plat valid without expiration. Improvement Permit with site plan valid for sixty months. Authorization to Construct is valid for a period equal to that of Improvement Permit – not to exceed sixty months.

Signed: Steve Turley date 7-14-04

Improvement Permit by: STEVE HEDRICK date 7-13-04

Authorization to Construct by: STEVE HEDRICK date 7-13-04

Installed by: R+H INCORPORATED

Operation Permit by: _____ date 7-21-04

Existing System Inspection by: _____ date _____

HEALTH DEPT. COPY: WHITE OWNER COPY (FINAL): YELLOW OWNER COPY (INITIAL): PINK