IREDELL COUNTY HEALTH DEPARTMENT

STATESVILLE 704-878-5305 MOORESVILLE 704-664-5281

This Voids All Previous Permits Issued

IMPROVEMENT PERMIT / AUTHORIZATION TO CONSTRUCT / OPERATION PERMIT / EXISTING SYSTEM INSPECTION

PERMIT# 69674 PIN# 4711316122 DATE Dec 1799

OWNER OR CONTRACTOR Golden Rule Buildars (David Ring) PHONE: Business 201 0485 Home

ADDRESS PO Box 2618 Davidson NC 28036

LOCATION Old MTN South ® Buffalo Shoals ⓖ Laurel Cove Lot on Right before Harbor Watch entrance

SUBDIVISION Harbor Watch BLOCK / SECTION III LOT 68 LOT AREA 2.97 Ac SITE CLASS P5 DESIGN FLOW 360 L.T.A.R. .3

Septic Tank: 1000 Gallons; STB 825 Date 10-1-99
Pump Tank: Gallons; PT Date
Pump Make: Model Serial No.
Nitrification Field: No Fields 1 Square Feet 1200 Linear Feet 400
No Lines 4 Trench Width 36" Max Trench Bottom Depth 36" Gravel Depth 12"

☒ New System ☐ Repair System Type: I (II) III IV V VI
System Description: Conv. GRAVITY
Repair System Description: 3 Acre 26% Red + Pump
Maintenance Agreement Required: ☐ Yes ☒ No Possible

☒ House/Mod. Home No. Bedrooms 3
☐ Mobile Home No. Bathrooms 2
☐ Business No. Employees
☐ Other


☐ Slab ☒ Crawl Space ☐ Basement w/plumbing ☐ Basement wo/plumbing

Water Supply: ☒ Individual ☐ Public ☐ Community well


Comments/Conditions: Locate well 100ft from Septic System (Tank & Line) Buried
Follow all Setback Regulations

Comments/Conditions:

INITIAL SITE SKETCH

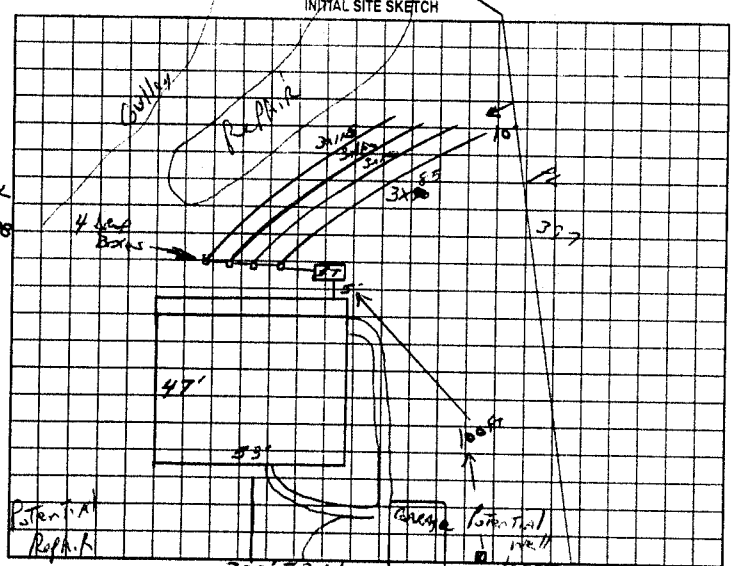

AS BUILT SKETCH

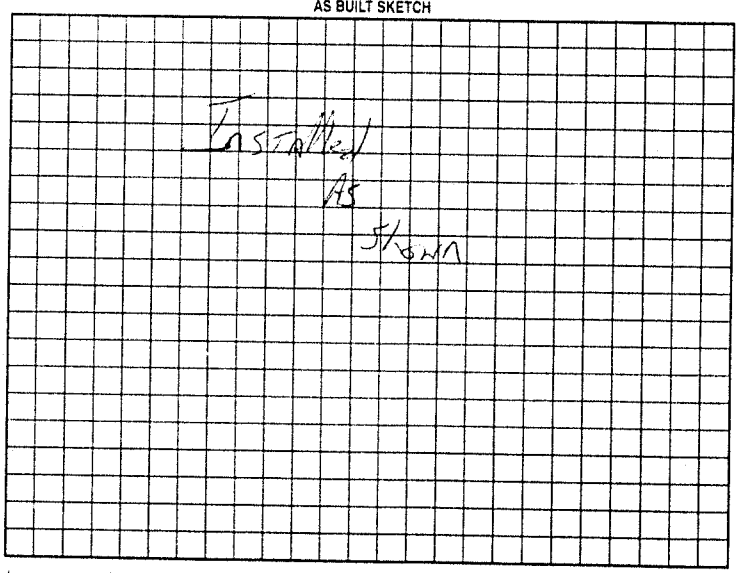

Permit can be suspended or revoked if any false information is supplied toward securing the permit/any unauthorized changes are made to the site/any unauthorized changes are made in the installation of the system. Improvement Permit with plat valid without expiration. Improvement Permit with site plan valid for sixty months. Authorization to Construct is valid for a period equal to that of Improvement Permit – not to exceed sixty months.

Signed: Donald R Mussa date Dec 20

Improvement Permit by: C Potter date Dec 1799

Authorization to Construct by: C Potter date Dec 1799

Installed by: C & W

Operation Permit by: C Potter date Feb 25 2000

Existing System Inspection by: date

HEALTH DEPT. COPY. WHITE OWNER COPY (FINAL) YELLOW OWNER COPY (INITIAL) PINK