CI

IREDELL COUNTY HEALTH DEPARTMENT

STATESVILLE 704-878-5305 MOORESVILLE 704-664-5281

IMPROVEMENT PERMIT / AUTHORIZATION TO CONSTRUCT / OPERATION PERMIT / EXISTING SYSTEM INSPECTION

PERMIT# 12426 I PIN# 4711-43-8558 DATE 10-18-04

OWNER OR CONTRACTOR VINCENT NATHANIEL PHONE: Business (704) 200-8886 Home

ADDRESS 109 GEMSTONE DR. STATESVILLE NC 28625

LOCATION I-40W TL OMR TR BUFFALO SHOALS RD TL LAUREL COVE RD 1 MILE ON LT.

SUBDIVISION BLOCK / SECTION LOT LOT AREA 0.985 SITE CLASS. PS DESIGN FLOW 360 L.T.A.R. 0.3 gpd/ft²

Septic Tank: 1000 Gallons; STB 1012 Date 5-17-04
Pump Tank: Gallons; PT Date
Pump Make: Model Serial No.
Nitrification Field: No Fields 1 Square Feet 1200 Linear Feet 400
No Lines 4 Trench Width 36" Max Trench Bottom Depth 36" Gravel Depth 12"

☑ New System ☐ Repair System Type: I (II) III, IV, V, VI
System Description: CONVENTIONAL GRAVITY
Repair System Description: GRAVITY 25% RED.
Maintenance Agreement Required: ☐ Yes ☑ No

☑ House/Mod. Home No. Bedrooms 3
☐ Mobile Home No. Bathrooms
☐ Business No. Employees
☐ Other


☐ Slab ☑ Crawl Space ☐ Basement w/plumbing ☐ Basement wo/plumbing

Water Supply: ☑ Individual ☐ Public ☐ Community


Comments/Conditions: ① INSTALL LINES ON CONTOUR
② MAINTAIN SETBACKS

Comments/Conditions: ZABEL FILTER & MARKER
SYSTEM INSTALLED BY WELL & HOUSE
WAS BUILT / DRILLED.
TANK & LIDS ARE 18" - 20' OFF MARKED PR which are

INITIAL SITE SKETCH 1"=50'

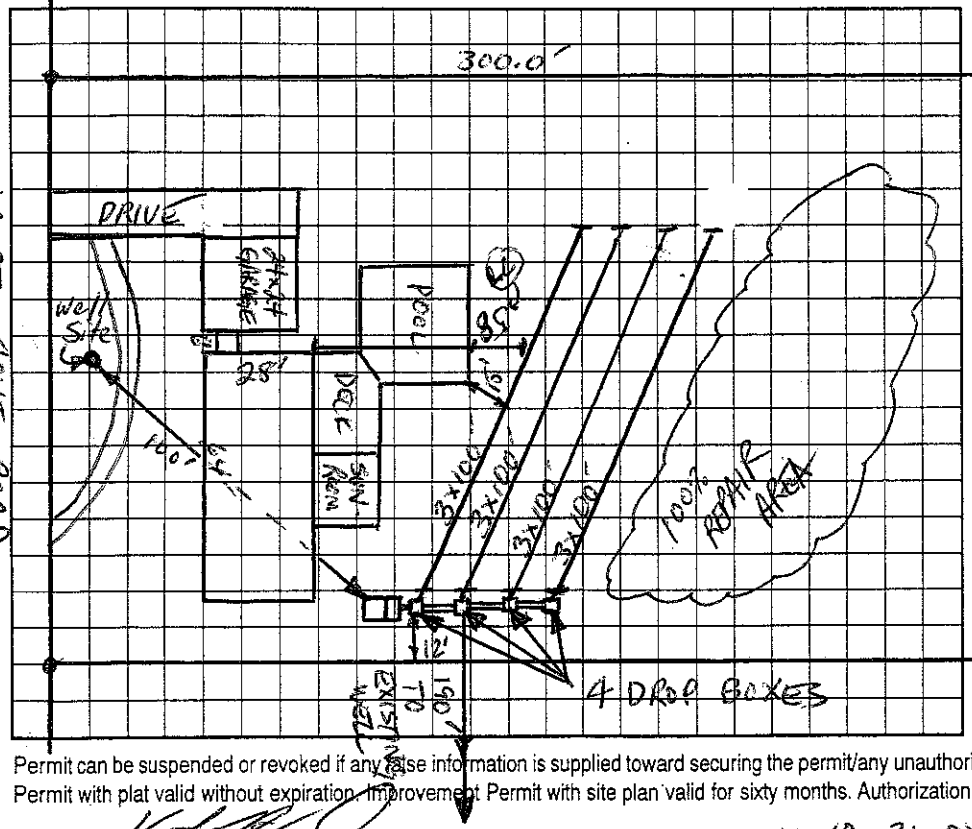

AS BUILT SKETCH

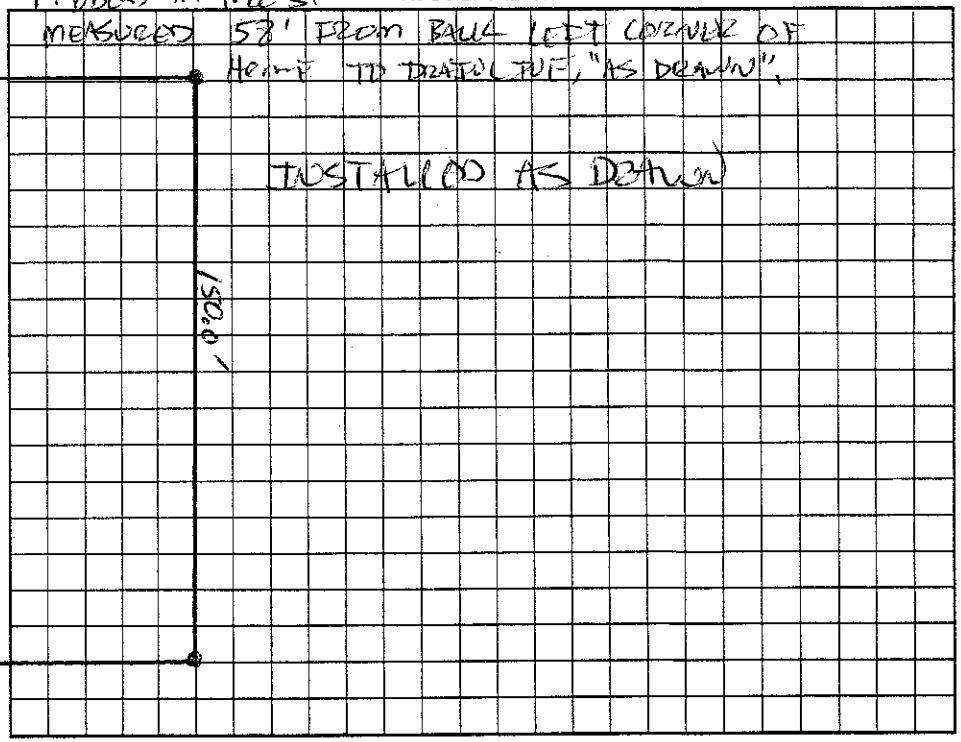

Permit can be suspended or revoked if any false information is supplied toward securing the permit/any unauthorized changes are made to the site/any unauthorized changes are made in the installation of the system. Improvement Permit with plat valid without expiration. Improvement Permit with site plan valid for sixty months. Authorization to Construct is valid for a period equal to that of Improvement Permit – not to exceed sixty months.

Signed: date 10-21-04 Installed by: A-1 BACKHOE

Improvement Permit by: Christopher M. Shaw LRS date 10-18-04 Operation Permit by: date 11-15-04

Authorization to Construct by: Christopher M. Shaw LRS date 10-21-04 Existing System Inspection by: date

HEALTH DEPT. COPY: WHITE OWNER COPY (FINAL): YELLOW OWNER COPY (INITIAL): PINK