CI II

IREDELL COUNTY HEALTH DEPARTMENT

STATESVILLE 704-878-5305 MOORESVILLE 704-664-5281

IMPROVEMENT PERMIT / AUTHORIZATION TO CONSTRUCT / OPERATION PERMIT / EXISTING SYSTEM INSPECTION

PERMIT# 14580 2 PIN# 4711-45-1610 0696 DATE 12-10-07

OWNER OR APPLICANT (CLAYTON) Homes PHONE: Business 336-495-2084 Home

ADDRESS 2036 Northside Drive Statesville NC 28677

LOCATION BUFFALO SHOALS WEST (2) LAUREL COVE BOX # 146 (ON PT

SUBDIVISION 2 OAKS BLOCK / SECTION LOT 4/5 LOT AREA 200X200 SITE CLASS. PS DESIGN FLOW 360 L.T.A.R. 1.3

EXISTING

Septic Tank: 1500 Gallons: STB Date

Pump Tank: Gallons: PT Date

Pump Make: Model Serial No.

Nitrification Field: No Fields 1 Square Feet 600-400 Linear Feet 68'

No Lines 2X34' Trench Width 24" Max Trench Bottom Depth 36" Gravel Depth N/A ☒Gravity ☐ Pressure

☒ New System ☐ Repair ☐ Expansion System Type: I II (III) IV V VI

System Description: 60% TM 50% RED II

Repair System Description: LP 50% RED II

Maintenance Agreement Required: ☐ Yes ☒ No

☐ House/Mod. Home ☒ Mobile Home ☐ Business ☐ Other


No. Bedrooms 3 No. Persons 6 No. Employees

Water Supply: ☒ Individual ☐ Public ☐ Community


☐ Slab ☒ Crawl Space ☐ Basement w/plumbing ☐ Basement wo/plumbing

Comments/Conditions: (1) OLD Lines will not back up to box by Shrubs elevations will later. (2) Install 2 new lines 34' LONG OF 50% REDUCTION AT ELDS using 2 NEW DEEP BOXES AS DRAWN (3) NEW DIST BOX MUST BE INSTALLED AT TANK. OLD ONE CRACKED. FOR LINES EQUAL WITH SPEED LEVELERS. (4) A consulting visit must take place BY INSTALLATION (5) This permit BASS A 3 BEDROOM SYSTEM up to A 3 BEDROOM

INITIAL SITE SKETCH

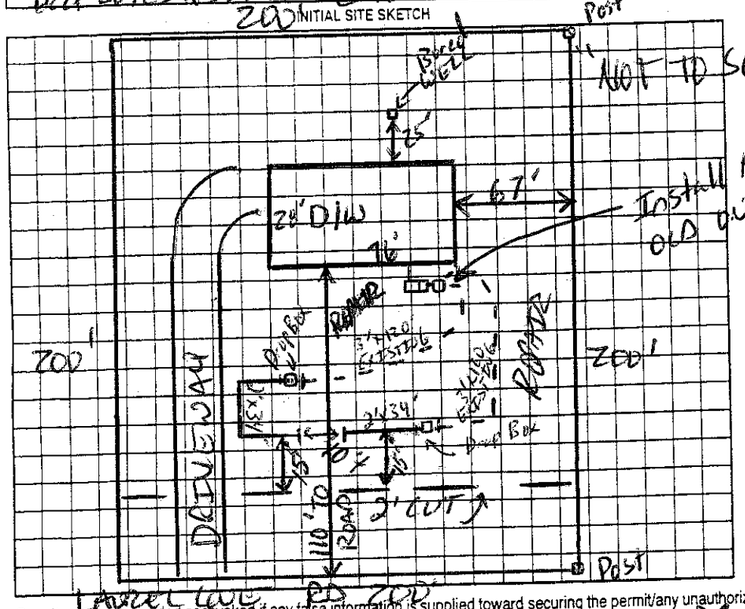

AS BUILT SKETCH

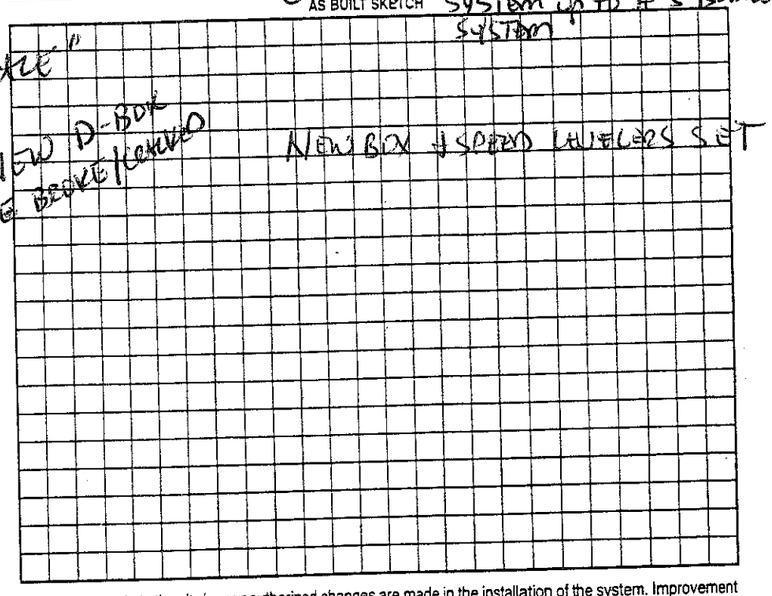

Permit can be suspended or revoked if any false information is supplied toward securing the permit/any unauthorized changes are made to the site/any unauthorized changes are made in the installation of the system. Improvement Authorization to Construct is valid for a period equal to that of Improvement Permit – not to exceed sixty months.

Permit with plat valid without expiration ☐ Improvement Permit with site plan valid for sixty months ☒

Signed: Deena Allen date 12/10/07

Improvement Permit by: date 12-12-07

Authorization to Construct by: date 12-12-07

Installed by: ABEE'S GRADING date 1-15-08

Operation Permit by: date

Existing System Inspection by: date

HEALTH DEPT. COPY: WHITE OWNER COPY (FINAL): YELLOW OWNER COPY (INITIAL): PINK