IREDELL COUNTY HEALTH DEPARTMENT

STATESVILLE 704-878-5305 MOORESVILLE 704-664-5281

IMPROVEMENT PERMIT / AUTHORIZATION TO CONSTRUCT / OPERATION PERMIT / EXISTING SYSTEM INSPECTION

PERMIT# 111598 PIN# 4711-45-1256 DATE 4-2-03

OWNER OR CONTRACTOR CECIL & DANA PRICE PHONE: Business Home 704-528-2066

ADDRESS 164 LAUREL COVE ROAD, STATESVILLE, NC 28677

LOCATION BUFFALO SHOALS ROAD, TL LAUREL COVE ROAD, HOUSE ON RIGHT AT BOX # 164

SUBDIVISION TWELVE OAKS BLOCK / SECTION LOT 1 LOT AREA 0.564 ACRE SITE CLASS PS DESIGN FLOW 360 L.T.A.R. EXISTING 0.35 GPD/FT²

Septic Tank: EXISTING Gallons: STB Date

Pump Tank: Gallons: PT Date

Pump Make: Model Serial No.

Nitrification Field: No Fields 1 Square Feet 315 Linear Feet 105

No Lines ONE Trench Width 36" Max Trench Bottom Depth 36" Gravel Depth 12"

☑ New System ☐ Repair System Type: I (II) III IV V VI

System Description: CONVENTIONAL, GRAVITY

Repair System Description: 50% REDUCTION, PUMP

Maintenance Agreement Required: ☐ Yes ☑ No

☑ House/Mod. Home No. Bedrooms 3

☐ Mobile Home No. Bathrooms 2

☐ Business No. Employees

☐ Other


☑ Slab ☐ Crawl Space ☐ Basement w/plumbing ☐ Basement wo/plumbing

Water Supply: ☑ Individual ☐ Public ☐ Community WELL


Comments:/Conditions: ① INTERCEPT LOWER DRAINLINE AT END AS SHOWN WITH NEW DROP BOXES FEEDING NEW 3' X 105' LINES ② EXCAVATE EXISTING DISTRIBUTION BOX AND SET SPEED LEVELERS FEEDING LOWER LINE LAST.

Comments:/Conditions:

INITIAL SITE SKETCH

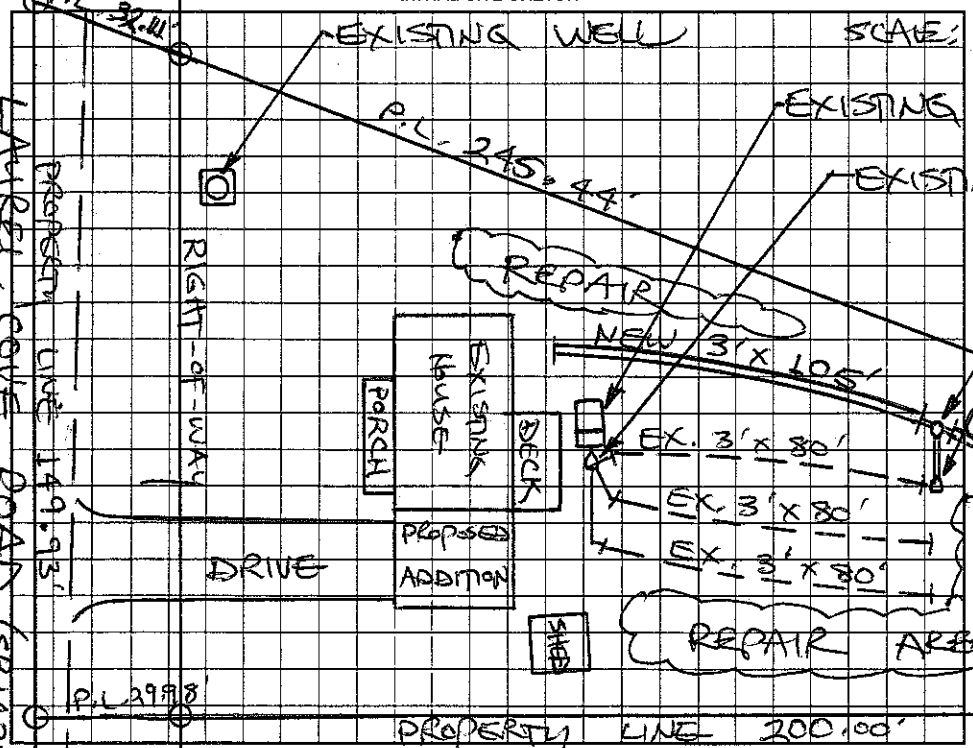

AS BUILT SKETCH

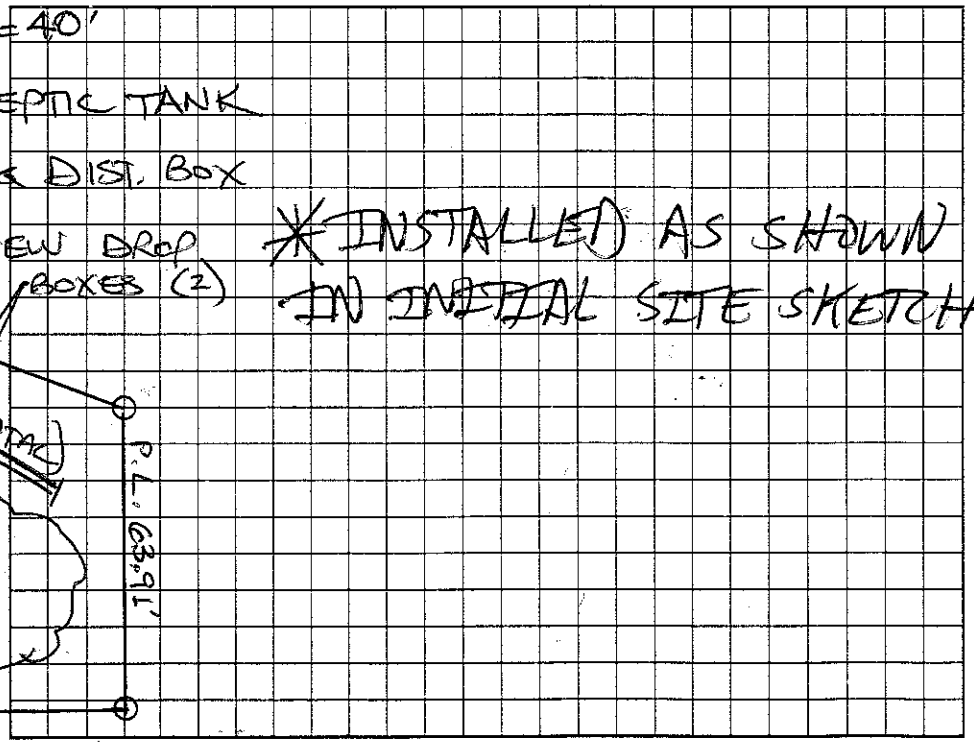

Permit can be suspended or revoked if any false information is supplied toward securing the permit/any unauthorized changes are made to the site/any unauthorized changes are made in the installation of the system. Improvement Permit with plat valid without expiration. Improvement Permit with site plan valid for sixty months. Authorization to Construct is valid for a period equal to that of Improvement Permit – not to exceed sixty months.

Signed: Dana Price date 4-7-03 Installed by: TUCKERS GRADING 04/28/03

Improvement Permit by: STEVE HEDRICK date 4-2-03 Operation Permit by: Patrick Mitchell date 04/28/03

Authorization to Construct by: STEVE HEDRICK date 4-2-03 Existing System Inspection by: date

HEALTH DEPT. COPY: WHITE OWNER COPY (FINAL): YELLOW OWNER COPY (INITIAL): PINK