IREDELL COUNTY HEALTH DEPARTMENT

Statesville Phone TR 3-7271 Mooresville Phone No. 664-5281

PERMIT TO INSTALL SEPTIC TANK

Permit No. _____ Permit Date 5-17 1973

Owner T.S. Compton Bldr Address Statesville N.C

Installed By Lackey Bro. Address Stony Point N.C.


Location of Property Out Buffalo Shoals Rd. to Rd # 1437. T.L. House on L. 1st house

| Tank | | Capacity | | Length of Lines | | Fixtures | |
|---|---|---|---|---|---|---|---|
| Block | ( ) | 1000 | (✓) | 225' | (✓) | No. of Baths | (1½) |
| Precast | (✓) | 1250 | ( ) | 250' | ( ) | Dishwasher | ( ) |
| | | 1500 | ( ) | Other _____ | | Garbage Grdr. | ( ) |
| | | Other _____ | | | | Other _____ | |

NOTIFY HEALTH DEPARTMENT AT LEAST EIGHT HOURS BEFORE TANK IS TO BE INSPECTED.

Final Inspection 5-17 1973 Approved (✓) Disapproved ( )

Remarks Community Water

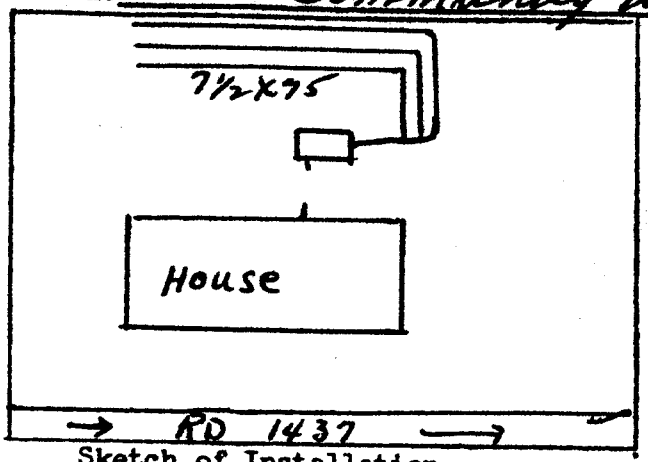


Sketch of Installation

E. G. Stevenson

Sanitarian