IREDELL COUNTY HEALTH DEPARTMENT

Statesville Phone TR 3-7271 Mooresville Phone No. 664-5281

PERMIT TO INSTALL SEPTIC TANK

Permit No. 471 Permit Date 6-12 1973

Owner R. B. Cook Address Statesville NC

Installed By Harlen Lackey Address Stony Point N.C.


Location of Property Out Buffalo Shoals Rd Past E. Mombo Rd. T.L. on Rd 1437. T.L. 1st Street Then T.R. Trailer on R.

| Tank | | Capacity | | Length of Lines | | Fixtures | |
|---|---|---|---|---|---|---|---|
| Block | ( ) | 1000 | ( ✓ ) | 225' | ( ✓ ) | No. of Baths | ( ) |
| Precast | ( ✓ ) | 1250 | ( ) | 250' | ( ) | Dishwasher | ( ) |
| | | 1500 | ( ) | Other | | Garbage Grdr. | ( ) |
| | | Other | | | | Other | |

NOTIFY HEALTH DEPARTMENT AT LEAST EIGHT HOURS BEFORE TANK IS TO BE INSPECTED.

Final Inspection 6-13 1973 Approved ( ✓ ) Disapproved ( )

Remarks Community Water

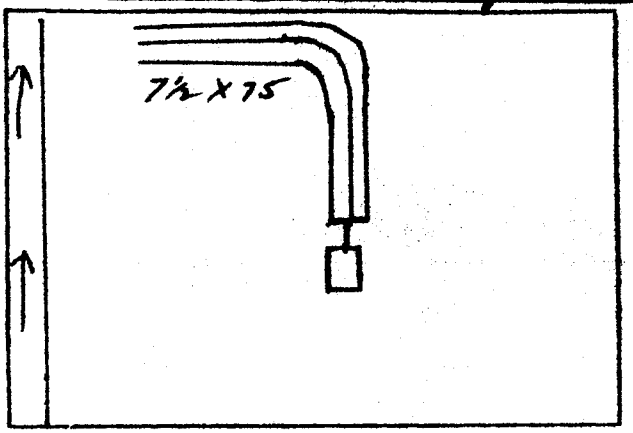


Sketch of Installation

Trailer not on lot at time of inspection

E. G. Stevenson

Sanitarian