62495

IREDELL COUNTY HEALTH DEPARTMENT

STATESVILLE 704-878-5305 MOORESVILLE 704-664-5281

IMPROVEMENT PERMIT / CERTIFICATE OF COMPLETION / OPERATION PERMIT / EXISTING SYSTEM INSPECTION

PROPERTY DESCRIPTION NO. 24321 DATE 7-25-96 TAX MAP NO. 36-4-A-15 Watershed: ☐ Yes ☒ No

OWNER OR CONTRACTOR Chris S. Davidson PHONE: Business 528 6192 Home WSIV PA

ADDRESS P.O. Box 5603 Sta

LOCATION Buffalo Shoals Past Trantham Trace Rd on Rt

SUBDIVISION Trantham Trace BLOCK / SECTION LOT 15 LOT AREA .528 acres SITE CLASS. PS DESIGN FLOW 246 L.T.A.R. .23

Septic Tank: 1000 Gallons; STB 794 Date 7-12-96

Pump Tank: Gallons; PT Date

Pump Make: Model Serial No.

Nitrification Field: No Fields 1 Square Feet 720 Linear Feet 240

No Lines 3 Trench Width 36" Max Trench Bottom Depth 24" Gravel Depth N/A

☐ New System ☐ Repair System Type: I, II, III, IV, V, VI

System Description: Gravity Chambers

Repair System Description: 1L 1L

Maintenance Agreement Required: ☐ Yes ☒ No

☒ House/Mod. Home No. Bedrooms 2

☐ Mobile Home No. Bathrooms 2

☐ Business No. Employees

☐ Other


☒ Slab ☐ Crawl Space ☐ Basement w/plumbing ☐ Basement wo/plumbing

Water Supply: ☒ Individual ☐ Community ☐ Public


Comments:

Comments:

INITIAL SITE SKETCH

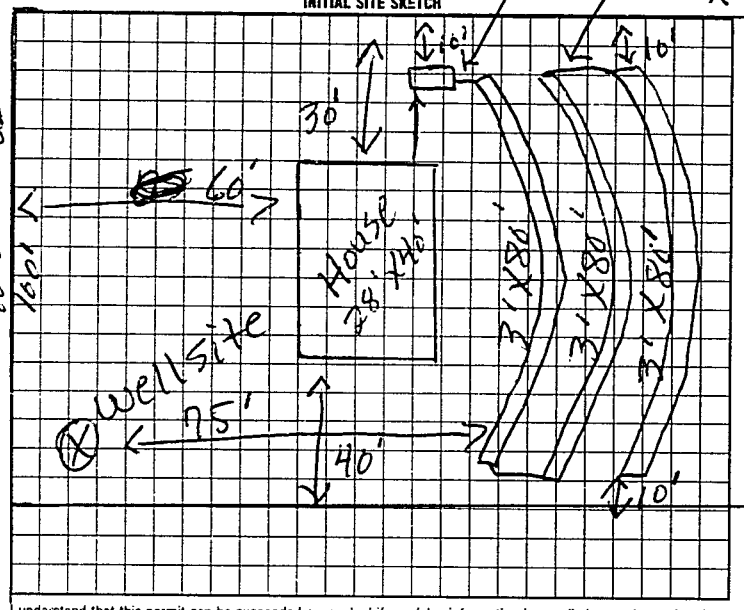

AS BUILT SKETCH

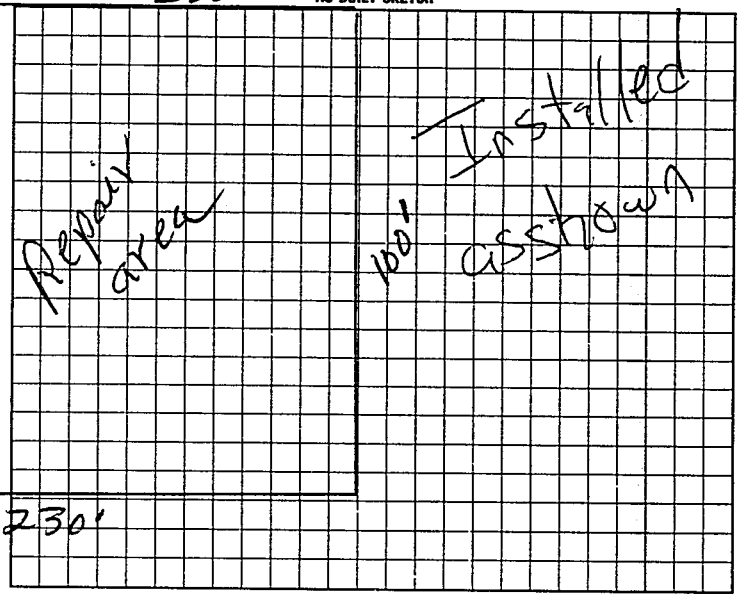

I understand that this permit can be suspended or revoked if any false information is supplied toward securing the permit/any unauthorized changes are made to the site/any unauthorized changes are made in the installation of the system.

Signed:

Improvement Permit by: L.C. Moore date 7-25-96

Authorization to Install by: L.C. Moore date 7-25-96

Installed by: Swain Enter.

Certificate of Completion by: RS date 9-24-96

Operation Permit by: date

HEALTH DEPT COPY WHITE INSPECTION COPY (FINAL) GREEN OWNER COPY (FINAL) YELLOW INSPECTION COPY (INITIAL) PINK OWNER COPY (INITIAL) BLUE

Authorization to Const Expires 6 months from Issue

00319 2