IREDELL COUNTY HEALTH DEPARTMENT

Statesville Phone TR 3-7271 Mooresville Phone NO 3-1271

PERMIT TO INSTALL SEPTIC TANK

Permit No. 296 Permit Date 4-30 19 71

Owner Ken Diskman Address Statesville

Installed By Lucky Brothers Address Stony Point


Location of Property Buffalo & Scales Road Post Rd. Cross Road about 3 miles on left. House Nott 2.

Tank		Capacity		Length of Lines		Fixtures	
Block	( )	1000	(✓)	225'	(2)	No. of Baths	(1)
Precast	(✓)	1250	( )	250'	( )	Dishwasher	( )
		1500	( )	Other		Garbage Grdr.	( )
		Other				Other	

NOTIFY HEALTH DEPARTMENT AT LEAST EIGHT HOURS BEFORE TANK IS TO BE INSPECTED.

Final Inspection 19 Approved ( ) Disapproved ( )

Remarks Comunity Water

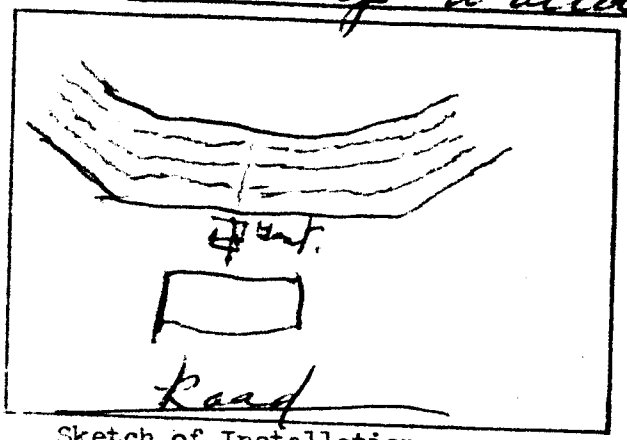

Sketch of Installation

Sanitarian