62503 4:00 62503

IREDELL COUNTY HEALTH DEPARTMENT

STATESVILLE 704-878-5305 MOORESVILLE 704-664-5281

IMPROVEMENT PERMIT / CERTIFICATE OF COMPLETION / OPERATION PERMIT / EXISTING SYSTEM INSPECTION

PROPERTY DESCRIPTION NO. 24320 DATE 7-25-96 TAX MAP NO. 304-A-14 Watershed: ☑ Yes ☐ No

OWNER OR CONTRACTOR Chris Davitson PHONE: Business 528-6192 Home WSIV PA

ADDRESS PO Box 5602 Statesville

LOCATION Buffalo Shoals Rd on Rt Part Trootman Trace Rd

SUBDIVISION Trootman Trace BLOCK / SECTION LOT 14 LOT AREA .528 acres SITE CLASS. PS DESIGN FLOW 240 L.T.A.R. .25

Septic Tank: 1000 Gallons; STB 794 Date 7-22-96

Pump Tank: Gallons; PT Date

Pump Make: Model Serial No.

Nitrification Field: No Fields 1 Square Feet 720 Linear Feet 240

No Lines 3 Trench Width 36" Max Trench Bottom Depth 24" Gravel Depth N/A

☑ New System ☐ Repair System Type: I, II, III IV, V, VI

System Description: Gravity Chambers

Repair System Description:

Maintenance Agreement Required: ☐ Yes ☐ No

☑ House/Mod. Home No. Bedrooms 3

☑ Mobile Home No. Bathrooms 2

☐ Business No. Employees

☐ Other


☐ Slab ☐ Crawl Space ☐ Basement w/plumbing ☐ Basement wo/plumbing

Water Supply: ☑ Individual ☐ Community ☐ Public


Comments:

Comments:

INITIAL SITE SKETCH

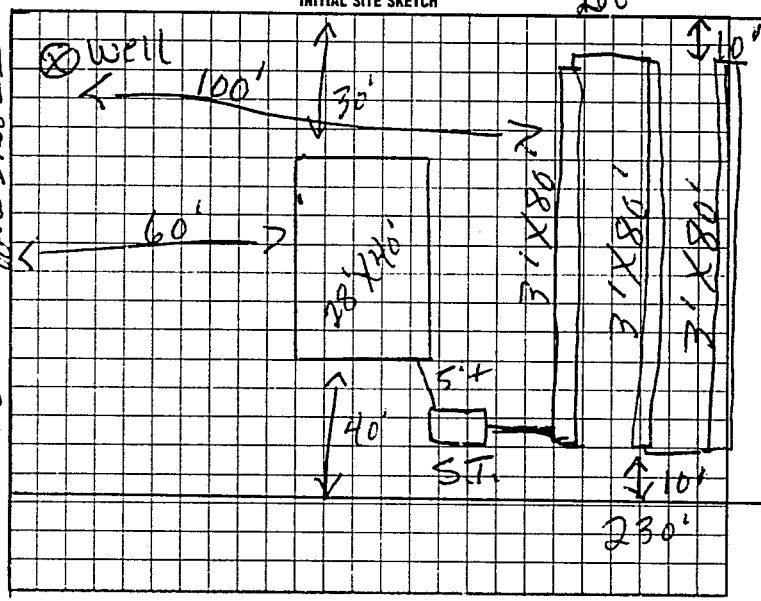

AS BUILT SKETCH

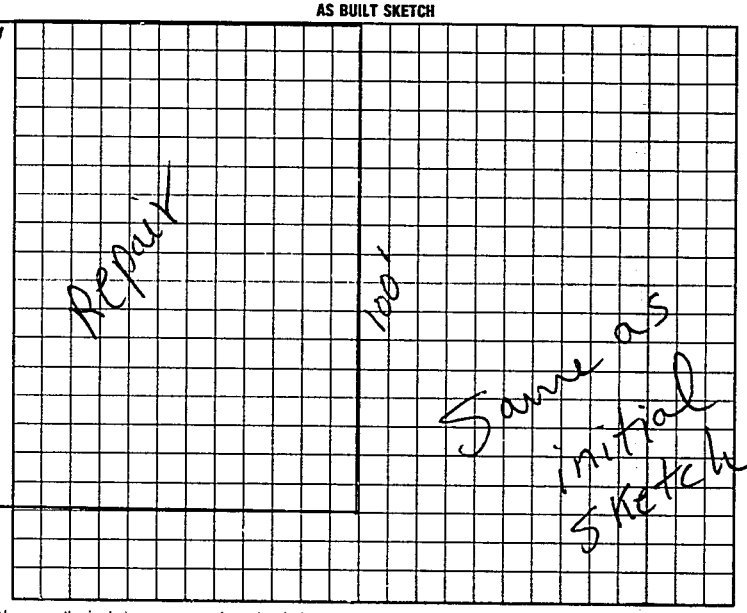

I understand that this permit can be suspended or revoked if any false information is supplied toward securing the permit/any unauthorized changes are made to the site/any unauthorized changes are made in the installation of the system.

Signed:

Improvement Permit by: R.C. Moore date 7-25-96

Authorization to Construct R.C. Moore date 7-25-96

Installed by: Eric Swain

Certificate of Completion by: date

Operation Permit by: R.C. Moore date 9-20-96

to construct DEPT COPY WHITE INSPECTION COPY (FINAL) GREEN OWNER COPY (FINAL) YELLOW INSPECTION COPY (INITIAL) PINK

Authorization to Const Expires 60 mos from issue

0 0 2 8 0 0