57318

IREDELL COUNTY HEALTH DEPARTMENT

THIS PERMIT VOIDS PREVIOUS ISSUED 8-26-95 AND 8-17-95

STATESVILLE 704-878-5305 MOORESVILLE 704-664-5281

IMPROVEMENT PERMIT / CERTIFICATE OF COMPLETION / OPERATION PERMIT / EXISTING SYSTEM INSPECTION

PROPERTY DESCRIPTION NO. 21434 DATE 9-25-95 TAX MAP NO. 3L-3-A-45 Watershed: ☒ PA ☐ No

OWNER OR CONTRACTOR TILLATHA DIAL PHONE: Business 528-6605 Home 873-5446

ADDRESS RT. 3, BOX 216 STATESVILLE, NC 28677

LOCATION BUFFALO SHOALS ROAD SW, TL LONG BRANCH RD, TR SAGEBRUSH RD, 2ND LOT ON LEFT

SUBDIVISION BUFFALO SHOALS PK BLOCK / SECTION LOT 45 LOT AREA ~3/4 ACRE SITE CLASS PS DESIGN FLOW 480 L.T.A.R. ~0.3 GPD/FT²

Septic Tank: 1000 Gallons; STB 797 Date 7-12-95

Pump Tank: 1000 Gallons; PT 27 Date 8-27-95

Pump Make: Liberty Model LESIA Serial No. 2457

Nitrification Field: No Fields 1 Square Feet EQUIVALENT TO 1536 Linear Feet 384

No Lines 4 Trench Width 36" Max Trench Bottom Depth 36" Gravel Depth N/A

☑ New System ☐ Repair System Type: I, II, ☒ IV, V, VI

System Description: PUMP-FED CHAMBERS

Repair System Description: PUMP-FED PPBPS

Maintenance Agreement Required: ☐ Yes ☒ No

☐ House/Mod. Home ☒ Mobile Home ☐ Business ☐ Other

No. Bedrooms 4 No. Bathrooms 2 No. Employees


☐ Slab ☒ Crawl Space ☐ Basement w/plumbing ☐ Basement wo/plumbing

Water Supply: ☐ Individual ☒ Community ☐ Public WELL NEXT DOOR


Comments: ① KEEP SYSTEM MINIMUMS 5' FROM MH, 15' FROM DITCH, 10' FROM WATER & PROPERTY LINES ② INSTALL 64 CHAMBERS AS SHOWN ③ USE PUMP SIZED TO DELIVER 48 GPM AT 14 TDH TO PRESSURE MANIFOLD W/ 4X3/4" TAPS

Comments: Checked Drainfield, septic tank, pump tank, pump and pressure manifold ok 10-3-95. Checked floats, Alarm and NEMA 4X box on 10-13-95. Could only install 15 chambers each line due to limited space.

INITIAL SITE SKETCH

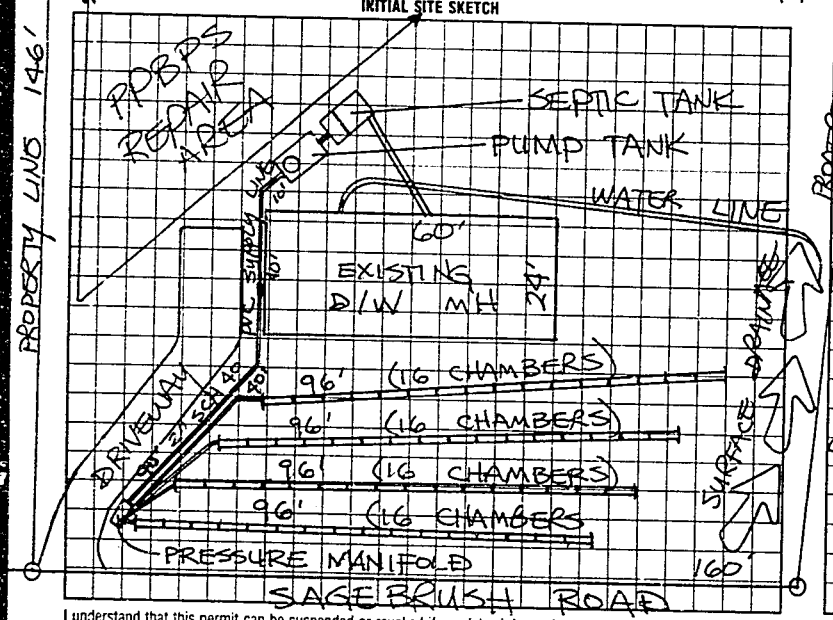

AS BUILT SKETCH Line lengths average 95' each line.

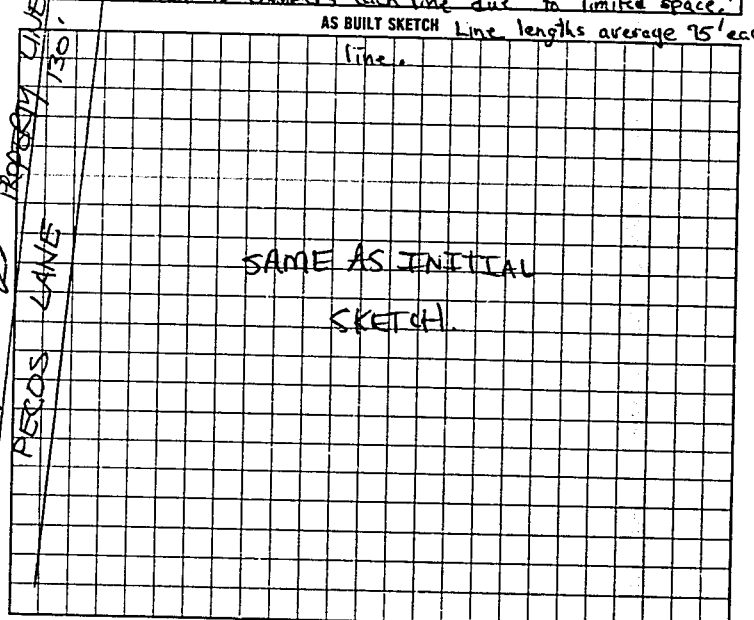

I understand that this permit can be suspended or revoked if any false information is supplied toward securing the permit/any unauthorized changes are made to the site/any unauthorized changes are made in the installation of the system.

Signed: X Steve Hedrick

Improvement Permit by: STEVE HEDRICK date 9-25-95

Existing System Inspection by: _____ date _____

Installed by: A-1 Backhoe

~~Certificate of Completion by:~~ _____ date _____

Operation Permit by: STEVE HEDRICK date 10/13/95

HEALTH DEPT COPY: WHITE INSPECTION COPY (FINAL): GREEN OWNER COPY (FINAL): YELLOW INSPECTION COPY (INITIAL): PINK OWNER COPY (INITIAL): GOLD

821000