IREDELL COUNTY HEALTH DEPARTMENT

STATESVILLE 704-878-5305 CI MOORESVILLE 704-664-5281

IMPROVEMENT PERMIT / AUTHORIZATION TO CONSTRUCT / OPERATION PERMIT / EXISTING SYSTEM INSPECTION

PERMIT# 120530 PIN# 4711-46-7065 LEG DATE 11-9-04

OWNER OR CONTRACTOR GLADYS & JOHN DEBOSK PHONE: Business CLAYTON HOMES 704-662-3248 Home [redacted] 321-255-2153

ADDRESS 2460 LAVEMONT RD MELBOURNE, FL 32934

LOCATION BUFFALO SHOALS WEST (E) LONGBRANCH on RT (ODDER OF LONGBRANCH & PELOS

SUBDIVISION BUFFALO SHOALS BLOCK / SECTION LOT 48 LOT AREA 1.0 AC SITE CLASS PS DESIGN FLOW 240 L.T.A.R. .12

Septic Tank: 1000 Gallons; STB 1017 Date 6-23-04
Pump Tank: 1000 Gallons; PT 17 Date 5-22-04
Pump Make: WEBSTER Model GOULDS Serial No. S05463786
Nitrification Field: No Fields 1 Square Feet 2000 Linear Feet 400
No Lines 8 Trench Width 18" Max Trench Bottom Depth 12" Gravel Depth 8"

☒ New System ☐ Repair System Type: I, II, III, (IV) V, VI
System Description: LOW PRESSURE PIPE
Repair System Description: MAX FEASIBLE / NO REPAIR NEEDED
Maintenance Agreement Required: ☒ Yes ☐ No

☐ House/Mod. Home ☒ Mobile Home ☐ Business ☐ Other
No. Bedrooms 2 No. Bathrooms 2 No. Employees ___

☐ Slab ☒ Crawl Space ☐ Basement w/plumbing ☐ Basement wo/plumbing

Water Supply: ☐ Individual ☒ Public ☒ Community

Comments:/Conditions: (1) USE IN LINE PUMP FILTER IN PUMP TANK (2) DO NOT CUT FOR POSITIVE DRAINAGE. MUST BE BACKFILLED TO MEET THE REQMTS (3) NOTE 6" MINIMUM BACKFILL REQMT OF P.S. SOIL.

Comments:/Conditions: (4) MAINTAIN SETBACKS (5) LOT WAS DEEDED BY JULY 1, 1977, SEPTIC PRESS LINES CAN BE 5' FROM P/L (6) LOT WAS DEEDED BY JANUARY 1, 1983 SO REPAIR AREA IS NOT REQUIRED (7) ATTACHED DEED FOR LOT 48 IS DATED AUGUST 6, 1970

INITIAL SITE SKETCH

SEE ATTACHED PLANS FOR SYSTEM DESIGN BY ASHLY ROLLINS, LSS

AS BUILT SKETCH

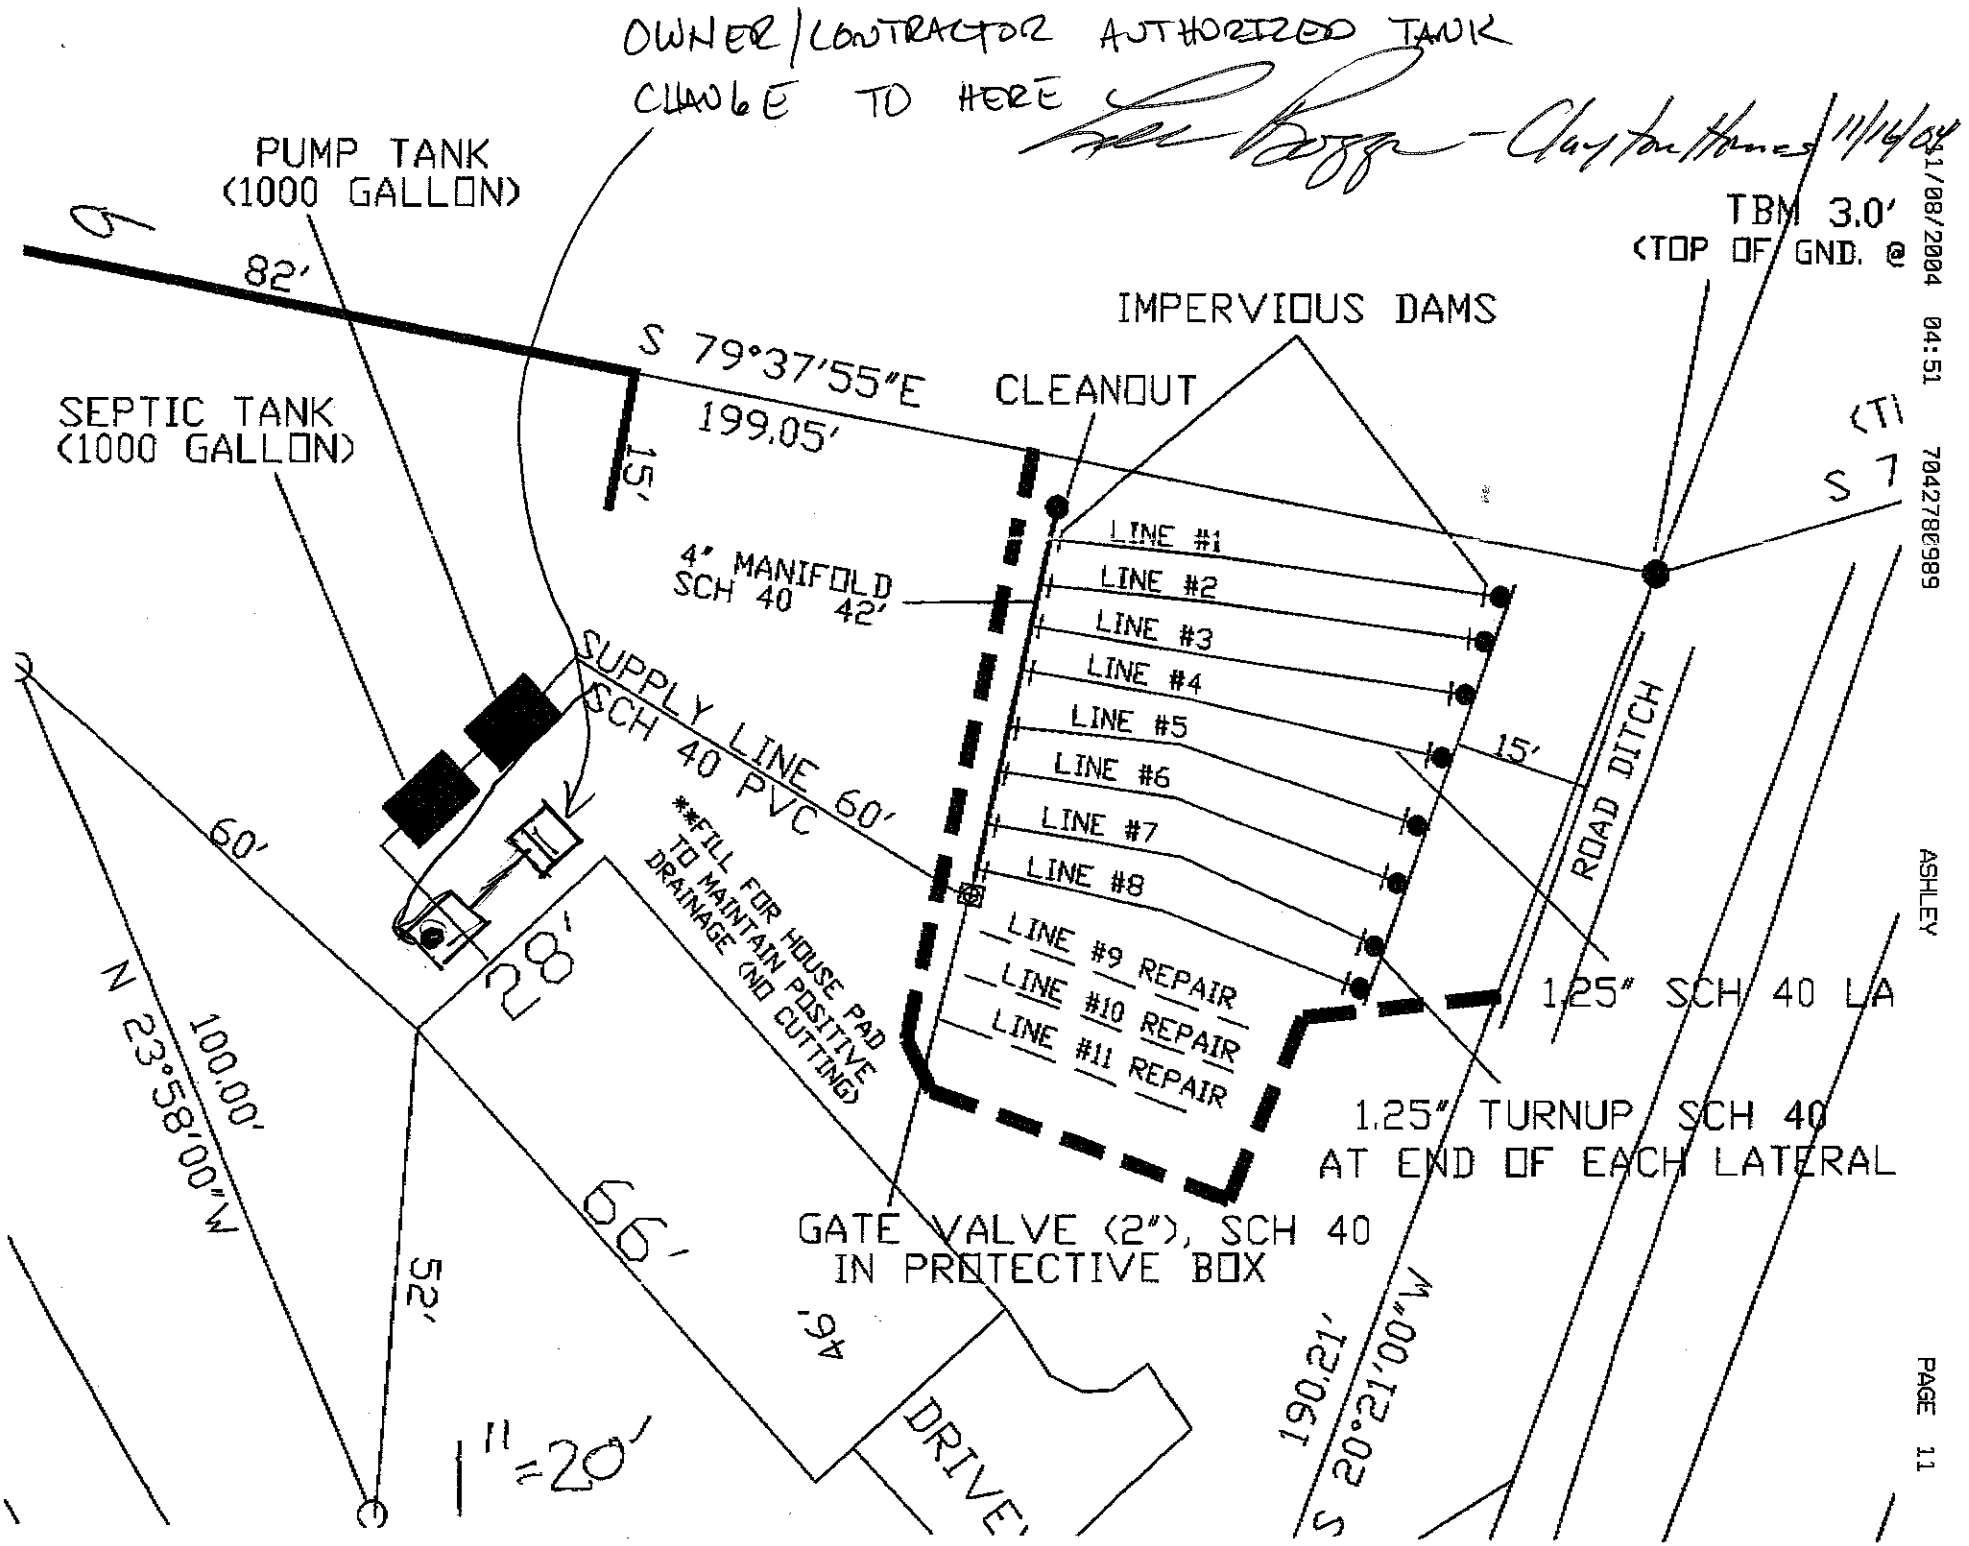
LABEL FILTER & MARKER 11-18-04
1" LINES & PRESSURE 11-19-04
NEEDS ELECTRICIAN / PUMP / 6" BACKFILL & CONTRACT
EVERYTHING ELSE OK
*NEEDS BREAKER BOX LABELED / 2 CIRCUITS
BREAKERS LABELED. EVERYTHING OK'D

Permit can be suspended or revoked if any false information is supplied toward securing the permit/any unauthorized changes are made to the site/any unauthorized changes are made in the installation of the system. Improvement Permit with plat valid without expiration. Improvement Permit with site plan valid for sixty months. Authorization to Construct is valid for a period equal to that of Improvement Permit – not to exceed sixty months.

Signed: _____ date 11-9-04
Improvement Permit by: _____ date 11-9-04
Authorization to Construct by: _____ date 11-9-04

Installed by: A-1 BACKHOE
Operation Permit by: _____ date 12-2-04
Existing System Inspection by: _____ date _____

HEALTH DEPT. COPY: WHITE OWNER COPY (FINAL): YELLOW OWNER COPY (INITIAL): PINK


OWNER/CONTRACTOR AUTHORIZED TANK CHANGE TO HERE
Clayton Homes 11/16/04
PUMP TANK (1000 GALLON)
SEPTIC TANK (1000 GALLON)
82'
S 79°37'55"E 199.05'
15'
CLEANOUT
IMPERVIOUS DAMS
TBM 3.0' (TOP OF GND. @
4" MANIFOLD SCH 40 42'
LINE #1
LINE #2
LINE #3
LINE #4
LINE #5
LINE #6
LINE #7
LINE #8
LINE #9 REPAIR
LINE #10 REPAIR
LINE #11 REPAIR
15'
ROAD DITCH
SUPPLY LINE 60' SCH 40 PVC
**FILL FOR HOUSE PAD TO MAINTAIN POSITIVE DRAINAGE (NO CUTTING)
1.25" SCH 40 LA
1.25" TURNUP SCH 40 AT END OF EACH LATERAL
60'
N 23°58'00"W 100.00'
28'
66'
46'
52'
GATE VALVE (2"), SCH 40 IN PROTECTIVE BOX
S 20°21'00"W 190.21'
DRIVE
1" = 20'
11/08/2004 04:51 7042780989
ASHLEY
PAGE 11