IREDELL COUNTY HEALTH DEPARTMENT

STATESVILLE 704-878-5305 MOORESVILLE 704-664-5281

IMPROVEMENT PERMIT / AUTHORIZATION TO CONSTRUCT / OPERATION PERMIT / EXISTING SYSTEM INSPECTION

PERMIT# 076280 PIN# 4711 46 7189 DATE 9-8-98

OWNER OR CONTRACTOR GARY A. BOST PHONE: Business Home 528-3144

ADDRESS 115 SAGEBRUSH, STATESVILLE, NC 28677

LOCATION BUFFALO SHOALS ROAD, TL LONGBRANCH, TR SAGEBRUSH, TL RECOS, 2ND ON (L)

SUBDIVISION W.R. KALE BLOCK / SECTION LOT 47 LOT AREA 0.65 ACRE SITE CLASS. PS DESIGN FLOW 240 L.T.A.R. 0.25 GPD/FT²

Septic Tank: 1000 Gallons; STB 794 Date 5-25-98

Pump Tank: Gallons; PT Date

Pump Make: Model Serial No.

Nitrification Field: No Fields 1 Square Feet EQ TO 960 Linear Feet 240+

No Lines FOUR Trench Width 36" Max Trench Bottom Depth 36"

☑ New System ☐ Repair System Type: I, II, III, IV, V, VI

System Description: CHAMBERED GRAVITY 25% REDUCTION

Repair System Description: ~~CONVENTIONAL PUMP~~

Maintenance Agreement Required: ☐ Yes ☑ No

~~Gravel~~ Depth SAND 6" ☐ Slab ☑ Crawl Space ☐ Basement w/plumbing ☐ Basement wo/plumbing

☐ House/Mod. Home ☑ Mobile Home ☐ Business ☐ Other 2BR ONLY


No. Bedrooms 2 No. Bathrooms 1 No. Employees

Water Supply: ☑ Individual ☑ Public ☐ Community WELL


Comments:/Conditions: INSTALL 25% REDUCTION SYSTEM USING 40 CHAMBERS OR 24 HDS SECTIONS

Comments:/Conditions:

INITIAL SITE SKETCH SCALE: 1"=40'

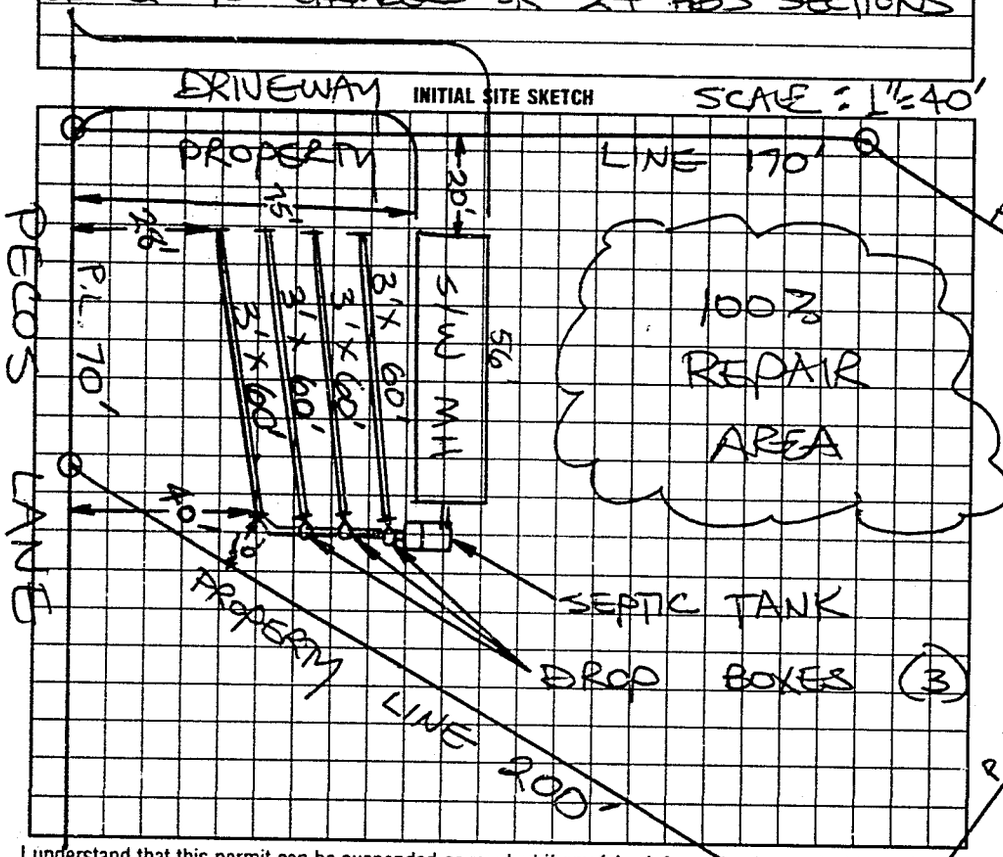

AS BUILT SKETCH

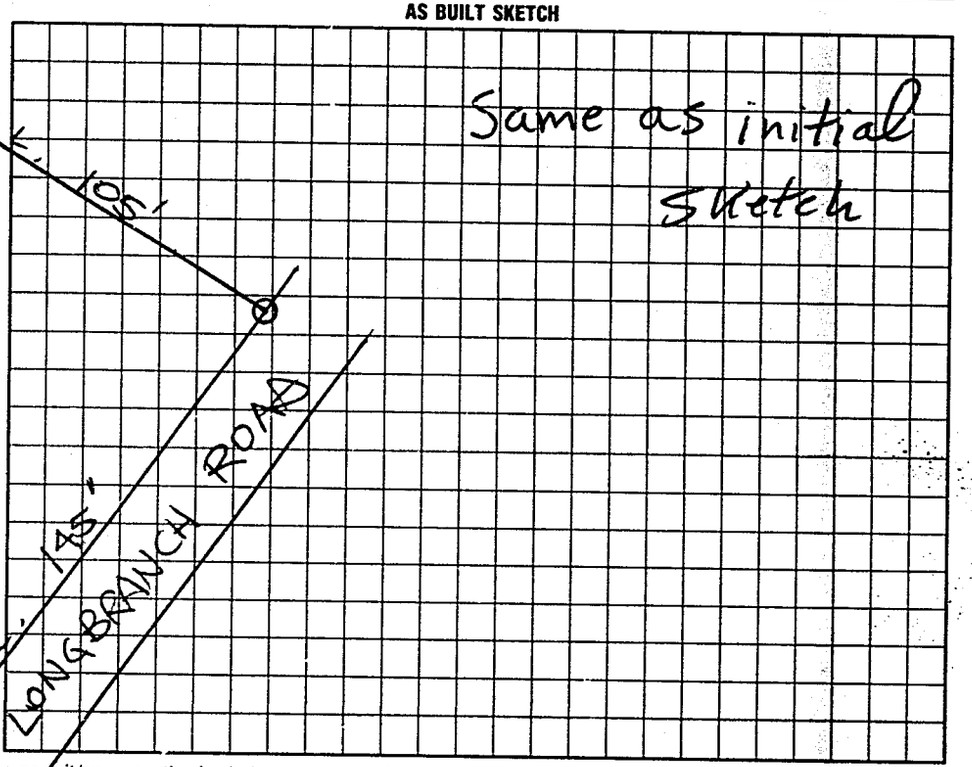

I understand that this permit can be suspended or revoked if any false information is supplied toward securing the permit/any unauthorized changes are made to the site/any unauthorized changes are made in the installation of the system. Improvement Permit with plat valid without expiration. Improvement Permit with site plan valid for sixty months. Authorization to Construct is valid for a period equal to that of Improvement Permit – not to exceed sixty months.

Signed: x Gary Bost date

Improvement Permit by: STEVE HEDRICK date 9-8-98

Authorization to Construct by: STEVE HEDRICK date 9-8-98

Installed by: Tim Ammons

Operation Permit by: L.C. Moore date 9-15-98

Existing System Inspection by: date

HEALTH DEPT. COPY: WHITE INSPECTION COPY (FINAL): GREEN OWNER COPY (FINAL): YELLOW INSPECTION COPY (INITIAL): PINK OWNER COPY (INITIAL): GOLD

98200