IREDELL COUNTY HEALTH DEPARTMENT

STATESVILLE 704-878-5305 MOORESVILLE 704-664-5281

IMPROVEMENT PERMIT / AUTHORIZATION TO CONSTRUCT / OPERATION PERMIT / EXISTING SYSTEM INSPECTION

PERMIT # 153731 PIN # 4711-46-7881 DATE 12-8-08

OWNER or APPLICANT Emily Little PHONE: Business Home: (704)402-3060 (cell)

OWNER or APPLICANT ADDRESS 2327 Buffalo Shoals Rd

LOCATION / DIRECTIONS Buffalo Shoals Rd, 2nd house on left after Long Branch Rd

SUBDIVISION BLOCK / SECTION LOT # LOT AREA DESIGN FLOW L.T.A.R. EXISTING

Septic Tank EXISTING Gallons: STB EXISTING Date

Pump Tank Gallons: PT Date

Pump Make Model Serial #

Nitrification Field No Fields No Lines Linear Feet 250'

Trench Width EXISTING Max. Trench Bottom Depth EXISTING Gravel Depth EXISTING ☑ GRAVITY ☐ PRESSURE

~~EXISTING~~ ☐ New System ☐ Repair ☐ Expansion System Type I (II) III IV V VI

System Description: EXISTING conventional gravel

Repair System Description: PUMP REPAIR

Maintenance Agreement Required ☐ YES ☑ NO

☑ Residence No. Bedrooms 3 ☐ Business No. Persons ☐ Other No. Employees ☐ Slab ☐ Crawl Space ☐ Basement w/plumbing ☐ Basement w/o plumbing

Water Supply: ☐ Private ☐ Public ☑ Community


Comments / Conditions

Comments / Conditions

* DEEP SYSTEM

INITIAL SITE SKETCH

AS BUILT SKETCH

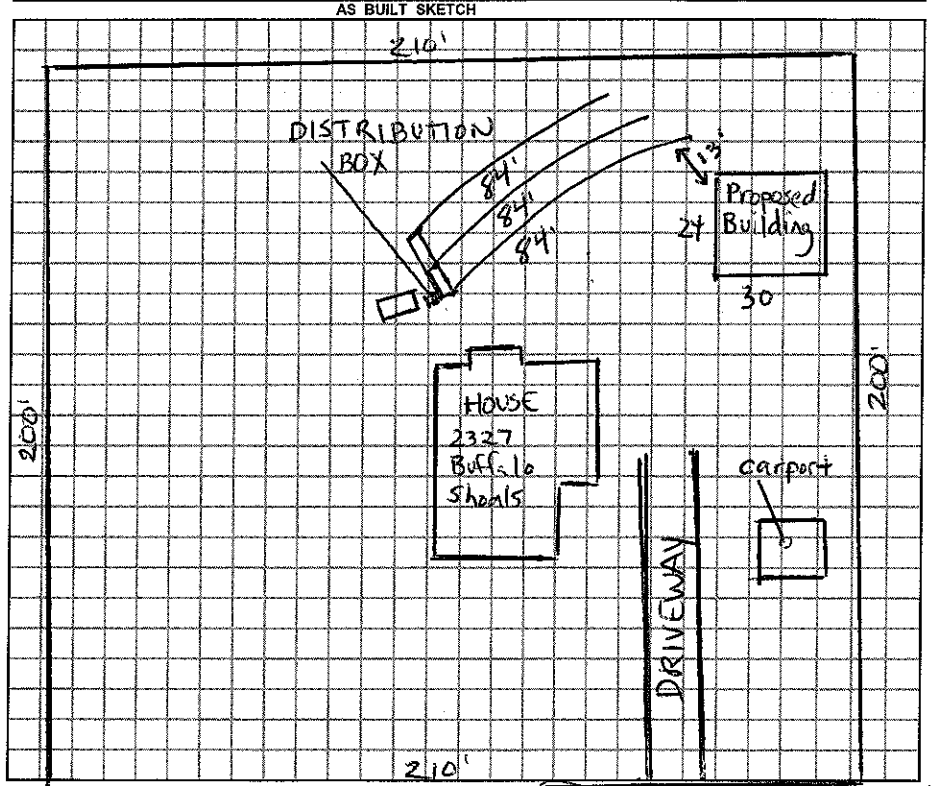

Permit can be suspended or revoked if any false information is supplied toward securing the permit / any unauthorized changes are made to the site / ~~any unauthorized changes are made~~ in the installation of the system.

☐ *IMPROVEMENT PERMIT w / plat valid without expiration.* ☐ *IMPROVEMENT PERMIT w / site plan valid for 60 mos.* ☐ *AUTHORIZATION TO CONSTRUCT valid for period equal to IMPROVEMENT PERMIT-not to exceed 60 mo.*

Owner / Applicant Signature: Date

Improvement Permit by: Date

Authorzation to Construct by: Date

YOU SHOULD CONTACT A LOCATOR SERVICE PRIOR TO ANY EXCAVATION.

Installed by:

Operation Permit by: Date:

Existing System Inspected by: Kyle Baker Date: 12/8/08

WHITE COPY Environmental Health YELLOW COPY (Final) Owner / Applicant PINK COPY (Initial) Owner / Applicant