IREDELL COUNTY HEALTH DEPARTMENT

STATESVILLE 704-878-5305 MOORESVILLE 704-664-5281

IMPROVEMENT PERMIT / CERTIFICATE OF COMPLETION / OPERATION PERMIT / EXISTING SYSTEM INSPECTION

PROPERTY DESCRIPTION NO. D66659 DATE 8-27-97 TAX MAP NO. 4711 46 4921 Watershed: ☐ Yes ☐ No

OWNER OR CONTRACTOR Chris Davidson (D-n) Enterprises PHONE: Business _____ Home _____ WS IV CA

ADDRESS PO Box 5602 Statesville NC

LOCATION Buffalo Shoals TR Before Laura Cove Rd to on L on hill

SUBDIVISION Troutman Trace BLOCK / SECTION 3 LOT 1 LOT AREA 21780 SITE CLASS. P/S DESIGN FLOW 240 L.T.A.R. 0.32

Septic Tank: 1000 Gallons; STB 1007 Date 4-16-98

Pump Tank: _____ Gallons; PT _____ Date _____

Pump Make: _____ Model _____ Serial No. _____

Nitrification Field: No Fields 1 Square Feet ~~750~~ Linear Feet 250

No Lines 5 Trench Width 36in Max Trench Bottom Depth 36in Gravel Depth 12in

☒ New System ☐ Repair System Type: I, II, III, IV, V, VI

System Description: Gravity Conventional

Repair System Description: ~~Gravity Conv~~ Chamber

Maintenance Agreement Required: ☐ Yes ☒ No HDS

☒ House/Mod. Home No. Bedrooms 2

☐ Mobile Home No. Bathrooms 2

☐ Business No. Employees _____

☐ Other _____


☐ Slab ☒ Crawl Space ☐ Basement w/plumbing ☐ Basement wo/plumbing

Water Supply: ☐ Individual ☒ Community ☐ Public well

Comments: Keep lines on center 9ft on center

Comments: ~~X~~ Note Turned House to Face Road

INITIAL SITE SKETCH

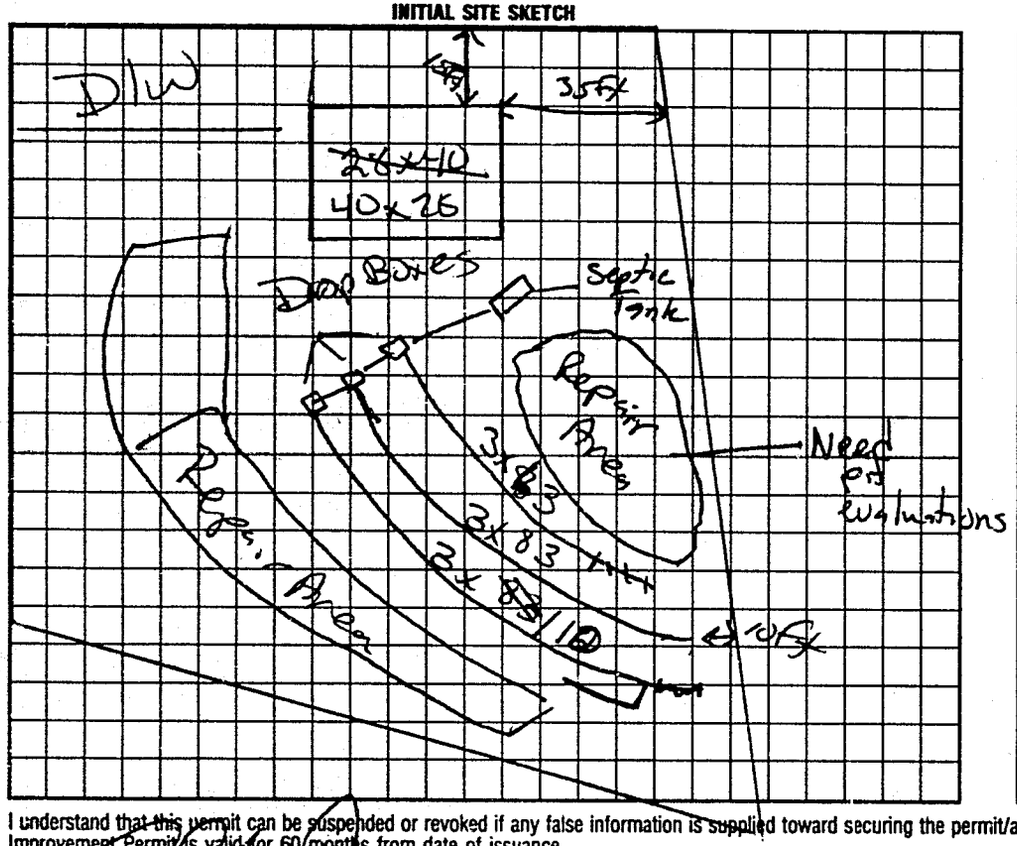

AS BUILT SKETCH

Installed as shown

I understand that this permit can be suspended or revoked if any false information is supplied toward securing the permit/any unauthorized changes are made to the site/any unauthorized changes are made in the installation of the system. Improvement Permit is valid for 60 months from date of issuance.

Signed: _____ Installed by: Charlie Brice

Improvement Permit by: Mark C. Ort RS date 8-27-97 Certificate of Completion by: _____ date _____

~~Existing System Inspection by~~ Authorization to Const. Mark C. Ort RS date 8-27-97 Operation Permit by: Mark C. Ort RS date 5-29-98

HEALTH DEPT. COPY: WHITE INSPECTION COPY (FINAL): GREEN OWNER COPY (FINAL): YELLOW INSPECTION COPY (INITIAL): PINK OWNER COPY (INITIAL): GOLD

96000