IREDELL COUNTY HEALTH DEPARTMENT

STATESVILLE 704-878-5305 MOORESVILLE 704-664-5281

IMPROVEMENT PERMIT / CERTIFICATE OF COMPLETION / OPERATION PERMIT / EXISTING SYSTEM INSPECTION

PROPERTY DESCRIPTION NO. 20360 DATE 2-21-95 TAX MAP NO. 3Q-4-B-1 Watershed: ☐ Yes ☑ No

OWNER OR CONTRACTOR Edward C. Hiott PHONE: Business _____ Home 528-6904

ADDRESS 188 Trautman Shoals Rd. Statesville, N.C. 28677

LOCATION I-40W To Old Mtn. Rd TR Buffalo Shoals Rd. TR Trautman Shoals Rd Lot near end on R.

SUBDIVISION Trautman Trace BLOCK / SECTION — LOT 1 LOT AREA 4.12 acre SITE CLASS. Existing DESIGN FLOW 360 L.T.A.R. Existing

Septic Tank: _____ Gallons; STB _____ Date _____

Pump Tank: Existing Gallons; PT _____ Date _____

Pump Make: _____ Model System Serial No. Inspection

Nitrification Field: No Fields ____ Square Feet _____ Linear Feet _____

No Lines _____ Trench Width _____ Max Trench Bottom Depth _____ Gravel Depth _____

☐ New System ☐ Repair System Type: I, II, III, IV, V, VI

System Description: Existing System

Repair System Description: Inspection

Maintenance Agreement Required: ☐ Yes ☐ No

☐ House/Mod. Home No. Bedrooms 3

☑ Mobile Home No. Bathrooms 2

☐ Business No. Employees ____

☐ Other _____


☐ Slab ☑ Crawl Space ☐ Basement w/plumbing ☐ Basement wo/plumbing

Water Supply: ☑ Individual ☐ Community ☐ Public


Comments:

Comments: Moving off SW MH and replacing with DW MH. System originally sized for a 3 bedroom dwelling. Keep new home min. 5' from any part of septic system. System shows no visible signs of malfunction at time of inspection

INITIAL SITE SKETCH

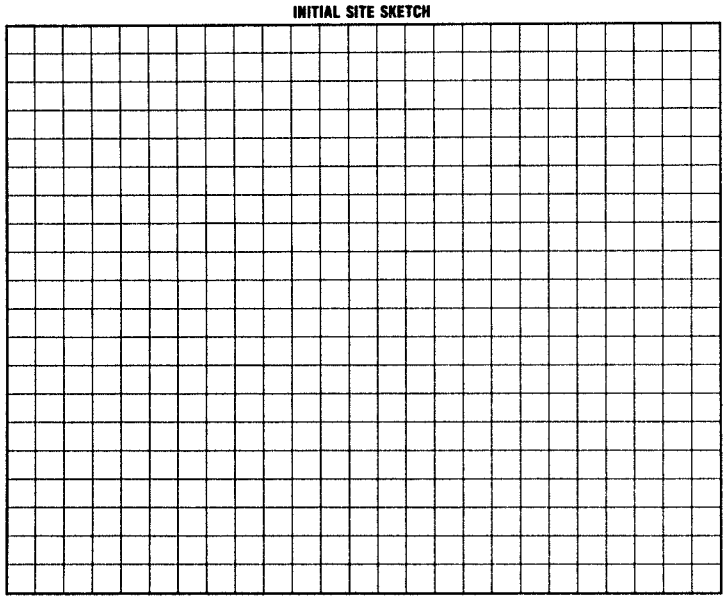

AS BUILT SKETCH

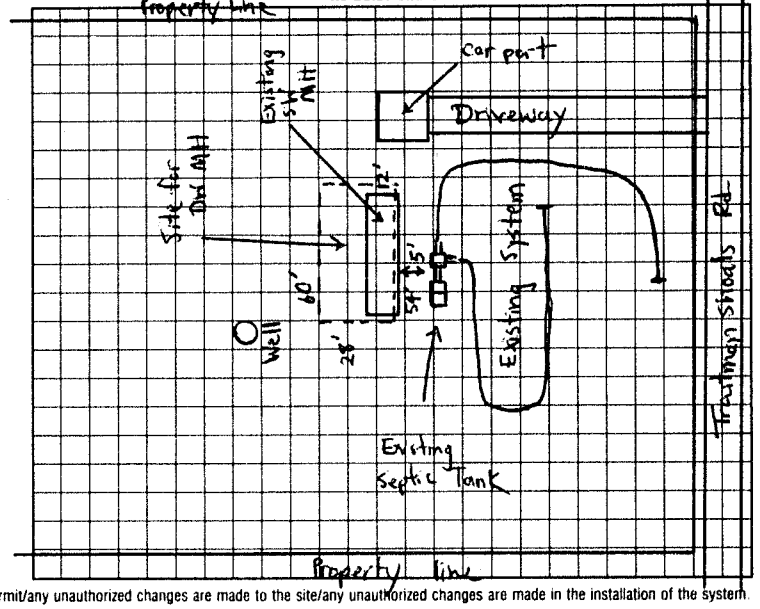

I understand that this permit can be suspended or revoked if any false information is supplied toward securing the permit/any unauthorized changes are made to the site/any unauthorized changes are made in the installation of the system. Improvement Permit is valid for 60 months from date of issuance.

Signed: _____ Installed by: _____

Improvement Permit by: _____ date _____ Certificate of Completion by: _____ date _____

Existing System Inspection by: Michael J. Dennis date 2-21-95 Operation Permit by: _____ date _____

HEALTH DEPT. COPY: WHITE INSPECTION COPY (FINAL): GREEN OWNER COPY (FINAL): YELLOW INSPECTION COPY (INITIAL) PINK OWNER COPY (INITIAL): GOLD