IREDELL COUNTY HEALTH DEPARTMENT

STATESVILLE 704-878-5305 MOORESVILLE 704-664-5281

IMPROVEMENT PERMIT / AUTHORIZATION TO CONSTRUCT / OPERATION PERMIT / EXISTING SYSTEM INSPECTION

PERMIT# 71023 PIN# 4711 47 3740 DATE 1-20-98

OWNER OR CONTRACTOR Chris Davidson PHONE: Business 528-6192 Home

ADDRESS PO BOX 252 Troutman N.C.

LOCATION Buffalo Shoals TR Clara Drive last lot left

SUBDIVISION Troutman Trac BLOCK / SECTION B LOT 6 LOT AREA .65Ac. SITE CLASS. PS DESIGN FLOW 240 L.T.A.R. .33

Septic Tank: 1000 Gallons; STB Date

Pump Tank: Gallons; PT Date

Pump Make: Model Serial No.

Nitrification Field: No Fields 1 Square Feet 720 Linear Feet 240

No Lines 4 Trench Width 36" Max Trench Bottom Depth 36" Gravel Depth 12"

☑ New System ☐ Repair System Type: I, II, III, IV, V, VI

System Description: Conv. Gravity

Repair System Description Gravity Chambers

Maintenance Agreement Required: ☐ Yes ☐ No GW HS

☐ House/Mod. Home No. Bedrooms 2

☐ Mobile Home No. Bathrooms 2

☐ Business No. Employees

☐ Other


☐ Slab ☐ Crawl Space ☐ Basement w/plumbing ☐ Basement wo/plumbing

Water Supply: ☐ Individual ☐ Public ☑ Community


Comments:/Conditions:

Comments:/Conditions:

INITIAL SITE SKETCH

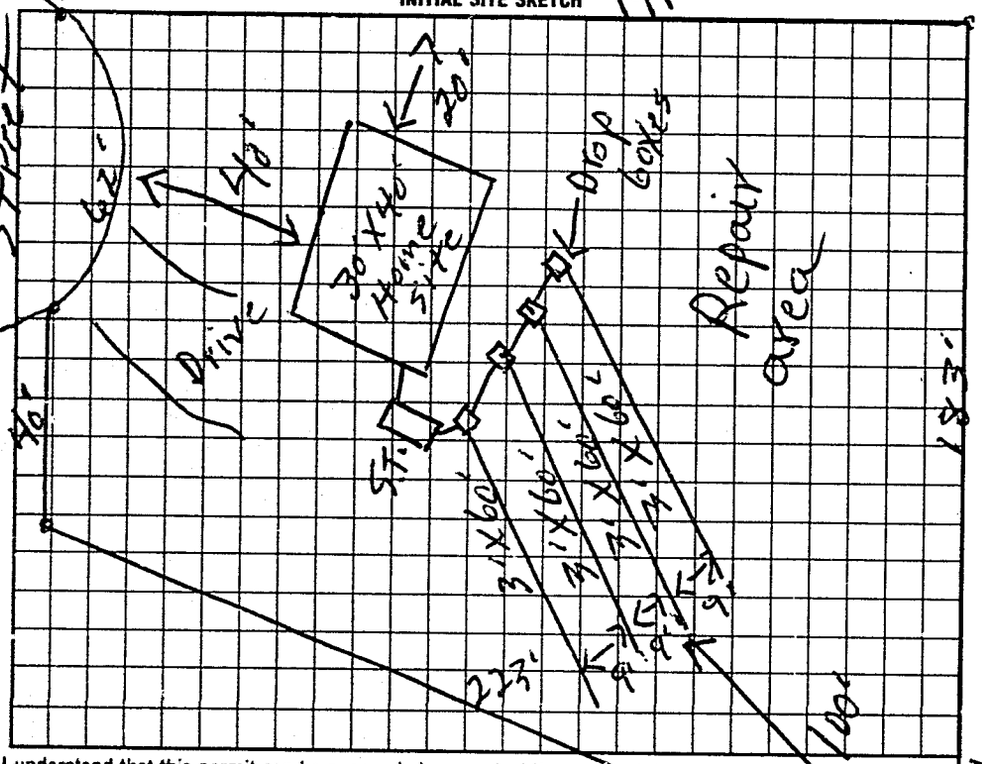

AS BUILT SKETCH

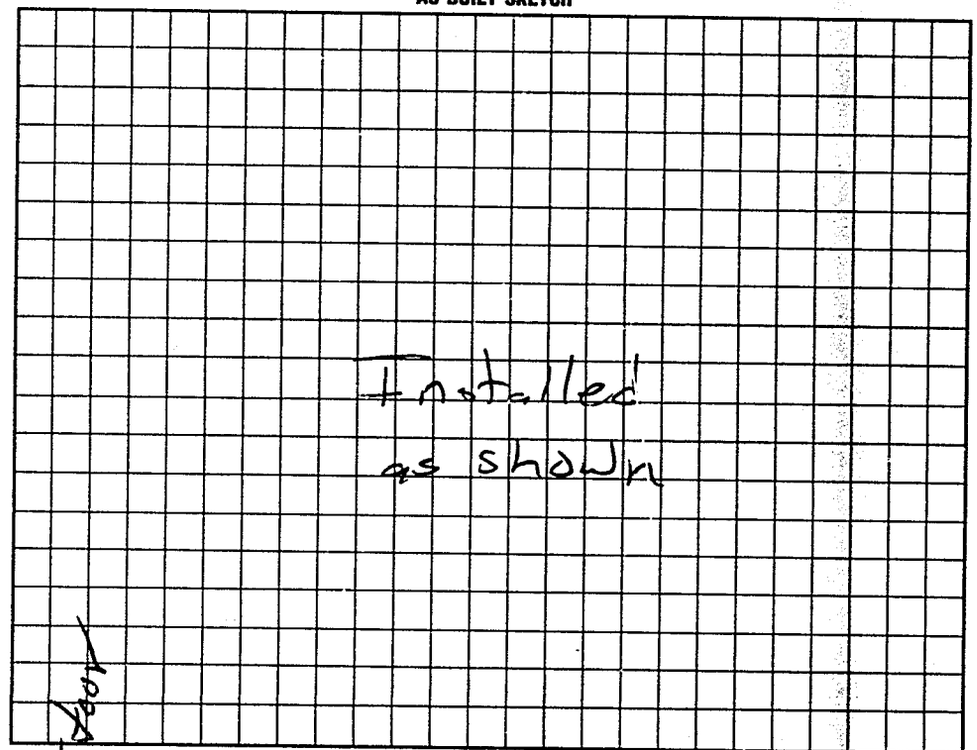

I understand that this permit can be suspended or revoked if any false information is supplied toward securing the permit/any unauthorized changes are made to the site/any unauthorized changes are made in the installation of the system. Improvement Permit with plat valid without expiration. Improvement Permit with site plan valid for sixty months. Authorization to Construct is valid for a period equal to that of Improvement Permit – not to exceed sixty months.

Signed: date

Improvement Permit by: R. C. Moore date 1-20-98

Authorization to Construct by: R. C. Moore date 1-20-98

Installed by: Charlie Brick

Operation Permit by: Mat Coffey RS date 6-24-98

Existing System Inspection by: date

HEALTH DEPT. COPY: WHITE INSPECTION COPY (FINAL): GREEN OWNER COPY (FINAL): YELLOW INSPECTION COPY (INITIAL): PINK OWNER COPY (INITIAL): GOLD

1860