IREDELL COUNTY HEALTH DEPARTMENT

STATESVILLE 704-878-5305 MOORESVILLE 704-664-5281

IMPROVEMENT PERMIT / CERTIFICATE OF COMPLETION / OPERATION PERMIT / EXISTING SYSTEM INSPECTION

PROPERTY DESCRIPTION NO. 25000 DATE 1-9-97 TAX MAP NO. 3Q-A-1C

OWNER OR CONTRACTOR Chris Davidson (D&D Enterprises) PHONE: Business 528-6192 Home

Watershed: ☐ Yes ☐ No WSIIIPA

ADDRESS PO Box 252 Troutman NC 28166

LOCATION Buffalo Shoals

SUBDIVISION Heatman Trace BLOCK / SECTION LOT 12 LOT AREA SITE CLASS. P/S DESIGN FLOW 240 L.T.A.R. 0.3

Septic Tank: 1000 Gallons; STB 1007 Date 4-15-97

Pump Tank: Gallons; PT Date

Pump Make: Model Serial No.

Nitrification Field: No Fields 1 Square Feet 600 Linear Feet 200

No Lines 3 Trench Width 36in Max Trench Bottom Depth 36in Gravel Depth —

☒ New System ☐ Repair System Type: I, II, III, IV, V, VI

System Description: Envirochamber

Repair System Description: (or Infiltrator Chamber/Equal)

Maintenance Agreement Required: ☐ Yes ☒ No

☒ House/Mod. Home No. Bedrooms 2

☐ Mobile Home No. Bathrooms 2

☐ Business No. Employees

☐ Other


☐ Slab ☒ Crawl Space ☐ Basement w/plumbing ☐ Basement wo/plumbing

Water Supply: ☐ Individual ☒ Community ☐ Public


Comments: Keep lines on contour, 9ft on center

Comments:

INITIAL SITE SKETCH

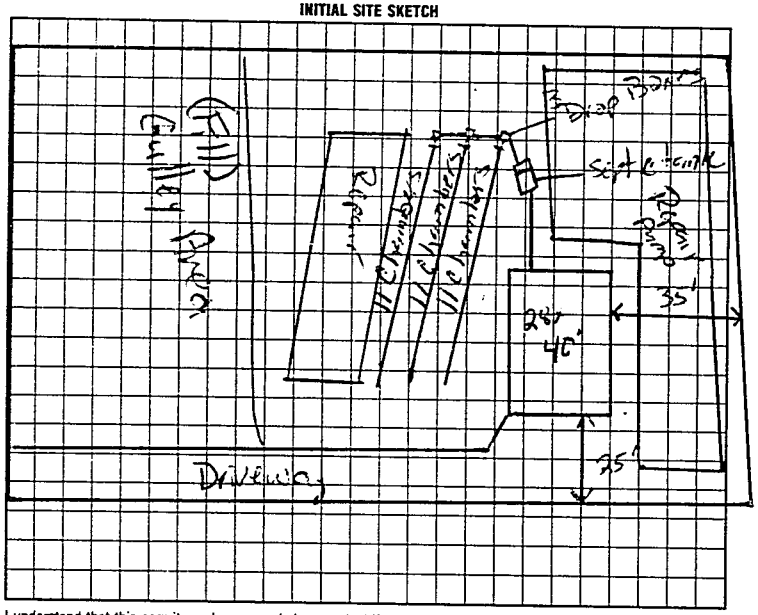

AS BUILT SKETCH

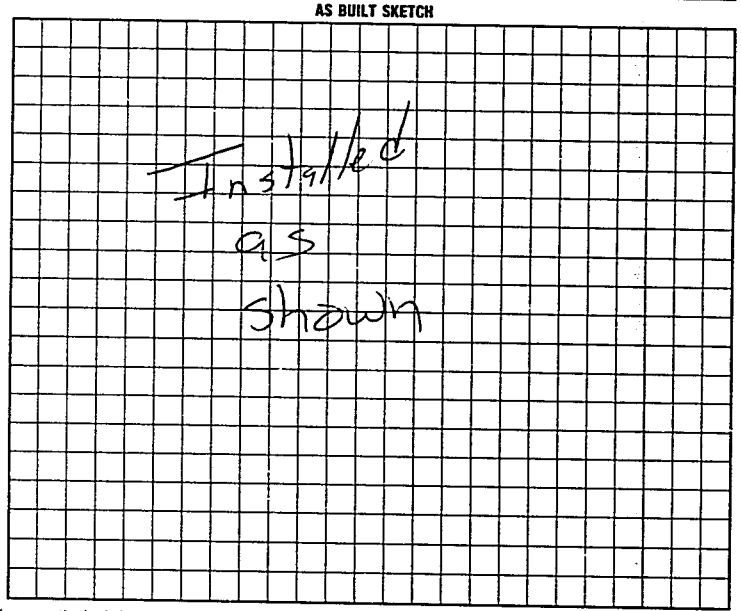

I understand that this permit can be suspended or revoked if any false information is supplied toward securing the permit/any unauthorized changes are made to the site/any unauthorized changes are made in the installation of the system. Improvement Permit is valid for 60 months from date of issuance. Authorization to Const. expires 5 yrs from issue date

Signed: Neal Keller

Improvement Permit by: Mark C Cuff RS date 1-9-97

Authorization to Const.

Existing System Inspection by: Mark C Cuff RS date 1-9-97

Installed by: Chris Davidson

Certificate of Completion by: date

Operation Permit by: Mark C Cuff RS date 5-29-97

HEALTH DEPT. COPY: WHITE INSPECTION COPY (FINAL): GREEN OWNER COPY (FINAL): YELLOW INSPECTION COPY (INITIAL): PINK OWNER COPY (INITIAL): GOLD

801000