IREDELL COUNTY HEALTH DEPARTMENT

STATESVILLE 704-878-5305 MOORESVILLE 704-664-5281

IMPROVEMENT PERMIT / AUTHORIZATION TO CONSTRUCT / OPERATION PERMIT / EXISTING SYSTEM INSPECTION

PERMIT# Repair PIN# DATE 3/21/01

OWNER OR CONTRACTOR CHRIS DAVIDSON PHONE: Business (704) 363-2634 Home

ADDRESS P. O. Box 5602 STATESVILLE, NC

LOCATION BUFFALO SHOALS RD. (R) CLARA DR. 2ND ON (R)

SUBDIVISION TROUTMAN TRACE BLOCK / SECTION 3 LOT 12 LOT AREA SITE CLASS. DESIGN FLOW L.T.A.R.

Septic Tank: EXISTING Gallons: STB Date

Pump Tank: Gallons: PT Date

Pump Make: Model Serial No

Nitrification Field: No Fields 1 Square Feet 540 Linear Feet 180'

No Lines 2 Trench Width 3' Max Trench Bottom Depth 36" Gravel Depth 12"

☐ New System ☑ Repair System Type: I (II) III, IV, V, VI

System Description:

Repair System Description: CONVENTIONAL

Maintenance Agreement Required: ☐ Yes ☑ No

☑ House/Mod. Home No. Bedrooms 2

☐ Mobile Home No. Bathrooms 2

☐ Business No. Employees

☐ Other


☐ Slab ☐ Crawl Space ☐ Basement w/plumbing ☐ Basement wo/plumbing

Water Supply: ☐ Individual ☐ Public ☑ Community

Comments/Conditions: ① NO CUTTING OR FILLING OVER DRAINFIELD AREAS ② KEEP ALL DRAINS AWAY FROM DRAINFIELD AREAS ③ MAINTAIN SETBACKS.

Comments/Conditions:

INITIAL SITE SKETCH

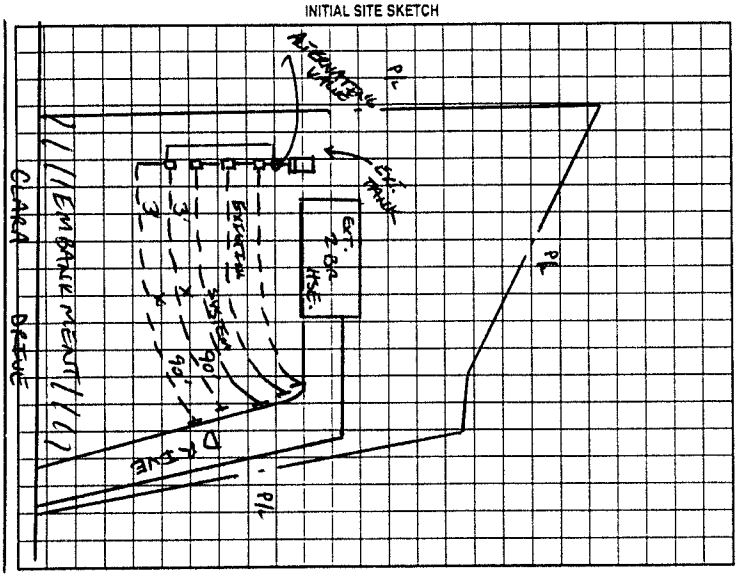

AS BUILT SKETCH

Installed as Designed

Permit can be suspended or revoked if any false information is supplied toward securing the permit/any unauthorized changes are made to the site/any unauthorized changes are made in the installation of the system. Improvement Permit with plat valid without expiration. Improvement Permit with site plan valid for sixty months. Authorization to Construct is valid for a period equal to that of Improvement Permit – not to exceed sixty months.

Signed: Neil Hale date 3-22-01 Installed by: David Jonitz

Improvement Permit by: Swaney Stines date 3/21/01 Operation Permit by: William G. Johnson date 5/14/01

Authorization to Construct by: Swaney Stines date 3/21/01 Existing System Inspection by: date

HEALTH DEPT COPY WHITE OWNER COPY (FINAL) YELLOW OWNER COPY (INITIAL) PINK