[redacted]ELL COUNTY HEALTH DEPARTMENT

STATESVILLE 704-878-5305 MOORESVILLE 704-664-5281

IMPROVEMENT PERMIT / CERTIFICATE OF COMPLETION / OPERATION PERMIT / EXISTING SYSTEM INSPECTION

PROPERTY DESCRIPTION NO. D66663 DATE 5-31-97 TAX MAP NO. 4711464921 Watershed: ☐ Yes ☐ No

OWNER OR CONTRACTOR Chris Davidson (D+D Enterprises) PHONE: Business 528-6192 Home

ADDRESS PO Box 5602 Statesville NC

LOCATION Buffalo Shoals TR Clarke Dr Past Troutman Shoals 2nd lot on (R)

SUBDIVISION Troutman Trace BLOCK / SECTION 3 LOT 12 LOT AREA SITE CLASS. PS DESIGN FLOW 240 L.T.A.R. 0.33

Septic Tank: 1000 Gallons; STB 1007 Date 11-10-97

Pump Tank: Gallons; PT Date

Pump Make: Model Serial No.

Nitrification Field: No Fields 1 Square Feet 750 Linear Feet 255

No Lines 3 Trench Width 36in Max Trench Bottom Depth 36in Gravel Depth 12in

☐ New System ☐ Repair System Type: I, II, III, IV, V, VI

System Description: Gravity Conventional

Repair System Description: Gravity Conventional

Maintenance Agreement Required: ☐ Yes ☒ No Pump

☒ House/Mod. Home ☐ Mobile Home ☐ Business ☐ Other

No. Bedrooms 3 No. Bathrooms 2 No. Employees


☐ Slab ☒ Crawl Space ☐ Basement w/plumbing ☐ Basement wo/plumbing

Water Supply: ☐ Individual ☒ Community ☐ Public


Comments: Keep lines on contour 9Ft on center
Keep water line 10Ft from system

Comments:

INITIAL SITE SKETCH

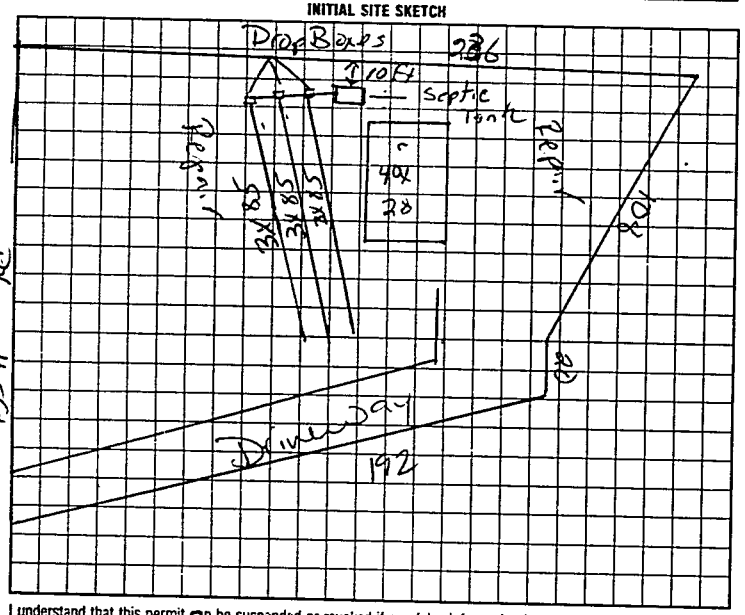

AS BUILT SKETCH

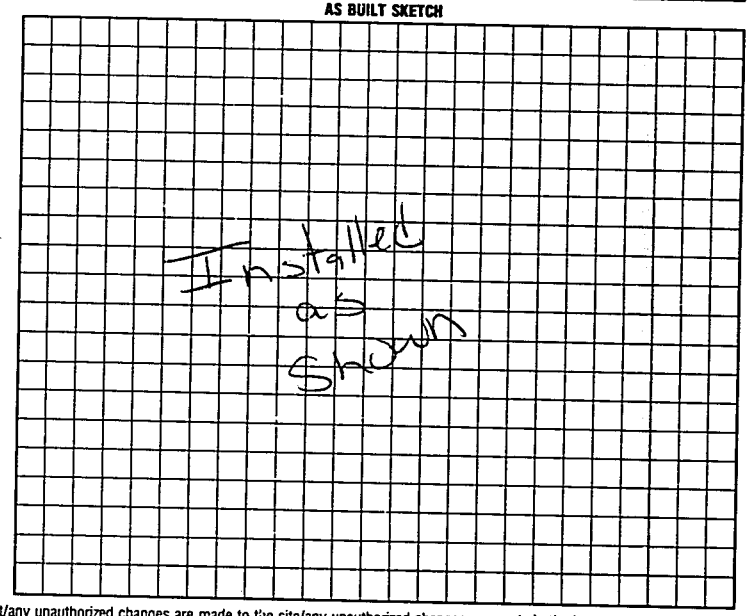

I understand that this permit can be suspended or revoked if any false information is supplied toward securing the permit/any unauthorized changes are made to the site/any unauthorized changes are made in the installation of the system. Improvement Permit is valid for 60 months from date of issuance.

Signed:

Improvement Permit by: Mark Cox RS date 5-31-97

Authorization to Const. Existing System Inspection by: Mark Cox RS date 5-31-97

Installed by: Chris Davidson

Certificate of Completion by: date

Operation Permit by: Mark Cox RS date 12-17-97

HEALTH DEPT. COPY: WHITE INSPECTION COPY (FINAL): GREEN OWNER COPY (FINAL): YELLOW INSPECTION COPY (INITIAL): PINK OWNER COPY (INITIAL): GOLD