IREDELL COUNTY HEALTH DEPARTMENT

STATESVILLE 704-878-5305 MOORESVILLE 704-664-5281

IMPROVEMENT PERMIT / CERTIFICATE OF COMPLETION / OPERATION PERMIT / EXISTING SYSTEM INSPECTION

PROPERTY DESCRIPTION NO. 066602 DATE 5-31-97 TAX MAP NO. 4711 46 4921 Watershed: ☐ Yes ☐ No

OWNER OR CONTRACTOR Chris Davidson (D&D Enterprises) PHONE: Business 528-6192 Home

ADDRESS PO Box 5602 Statesville NC

LOCATION Buffalo Shoals Rd TR Clara Dr Past Troutman Shoals 3 lot on (R)

SUBDIVISION Troutman Trace BLOCK / SECTION 3 LOT 11 LOT AREA 28775 SITE CLASS. P/S DESIGN FLOW 240 L.T.A.R. 0.3

Septic Tank: 1000 Gallons; STB 1207 Date 10-30-97

Pump Tank: _____ Gallons; PT _____ Date _____

Pump Make: _____ Model _____ Serial No. _____

Nitrification Field: No Fields 1 Square Feet 800 Linear Feet 266

No Lines 4 Trench Width 36in Max Trench Bottom Depth 36in Gravel Depth 12in

☒ New System ☐ Repair System Type: I, (II) III, IV, V, VI

System Description: _____

Repair System Description: _____

Maintenance Agreement Required: ☐ Yes ☐ No

☒ House/Mod. Home ☐ Mobile Home ☐ Business ☐ Other

No. Bedrooms 2 No. Bathrooms 2 No. Employees _____


☐ Slab ☒ Crawl Space ☐ Basement w/plumbing ☐ Basement wo/plumbing

Water Supply: ☐ Individual ☒ Community ☐ Public


Comments: Keep lines on contour 9ft on center
Keep waterline 10Ft from system

Comments:

INITIAL SITE SKETCH

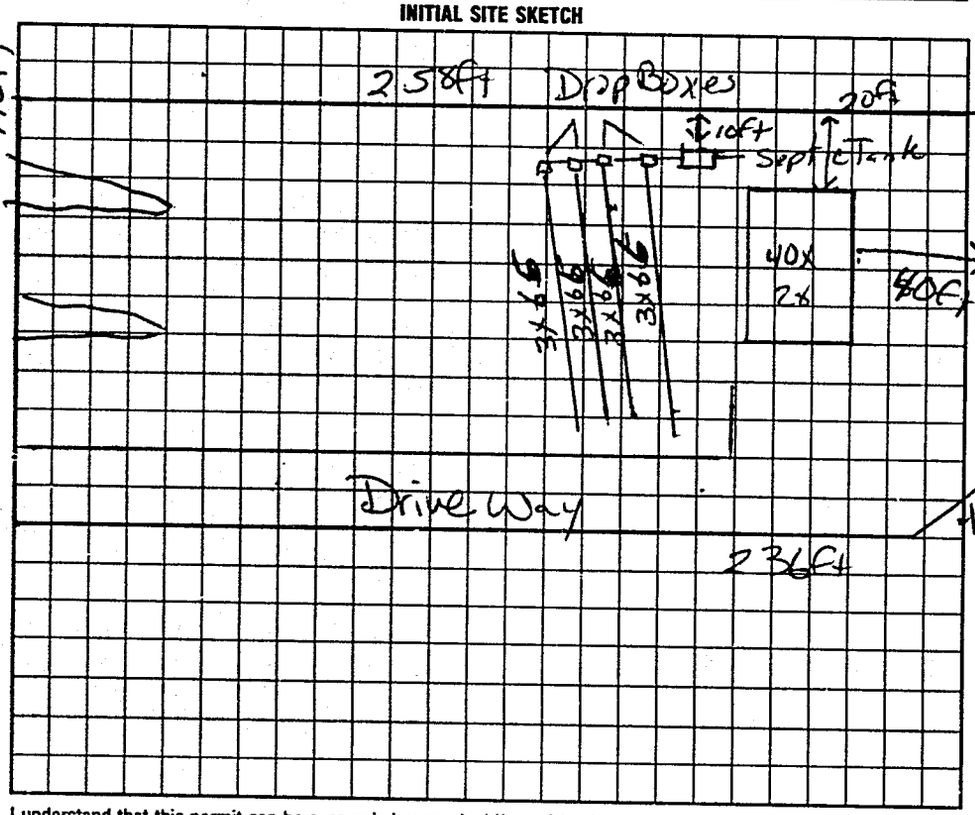

AS BUILT SKETCH

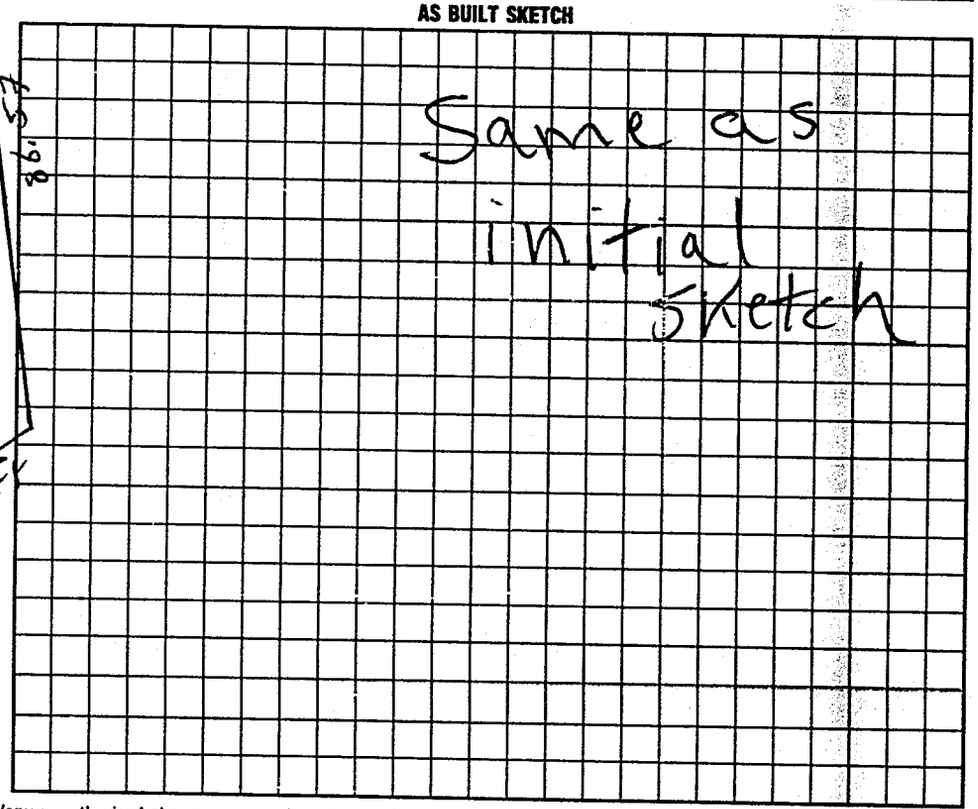

I understand that this permit can be suspended or revoked if any false information is supplied toward securing the permit/any unauthorized changes are made to the site/any unauthorized changes are made in the installation of the system. Improvement Permit is valid for 60 months from date of issuance. Authorization to construct expires 5yrs from issue date

Signed: _____

Improvement Permit by: Mary Coffers date 5-31-97

~~Existing System Inspection by~~ Authorization to construct: Mary Coffers date 5-31-97

Installed by: Chris Davidson

Certificate of Completion by: _____ date _____

Operation Permit by: D.C. Moore date 1-30-98

HEALTH DEPT. COPY: WHITE INSPECTION COPY (FINAL): GREEN OWNER COPY (FINAL): YELLOW INSPECTION COPY (INITIAL): PINK OWNER COPY (INITIAL): GOLD