IREDELL COUNTY HEALTH DEPARTMENT

STATESVILLE 704-878-5305 MOORESVILLE 704-664-5281

IMPROVEMENT PERMIT / CERTIFICATE OF COMPLETION / OPERATION PERMIT / EXISTING SYSTEM INSPECTION

PROPERTY DESCRIPTION NO. 069183 DATE 9-6-97 TAX MAP NO. 4711385472 PT Watershed: ☐ Yes ☐ No WS IV PA

OWNER OR CONTRACTOR Chris Davidson (D&D Enterprises) PHONE: Business 528-6192 Home

ADDRESS PO Box 5602 Statesville NC 28687

LOCATION Buffalo Shoals Rd TR Clara Drive lot on (R) Before end

SUBDIVISION Trautman Trace BLOCK / SECTION LOT 10 LOT AREA 21780 SITE CLASS. P/S DESIGN FLOW 240 L.T.A.R. 0.35

Septic Tank: 1000 Gallons; STB 1007 Date 2-25-98

Pump Tank: Gallons; PT Date

Pump Make: Model Serial No.

Nitrification Field: No Fields 1 Square Feet 690 Linear Feet 230

No Lines 3 Trench Width 36in Max Trench Bottom Depth 36in Gravel Depth 12 in

☒ New System ☐ Repair System Type: I (II) III, IV, V, VI

System Description: Gravity Conventional

Repair System Description: Conventional Gravity/Pump

Maintenance Agreement Required: ☐ Yes ☒ No

☒ House/Mod. Home ☐ Mobile Home ☐ Business ☐ Other

No. Bedrooms 3 No. Bathrooms 2 No. Employees


☐ Slab ☑ Crawl Space ☐ Basement w/plumbing ☐ Basement wo/plumbing

Water Supply: ☐ Individual ☑ Community ☐ Public well


Comments: Keep Lines on contour, min 9ft on center
Keep water line 10ft from system

Comments: Note Tank sits 30ft from corner of House 10ft from property line

INITIAL SITE SKETCH

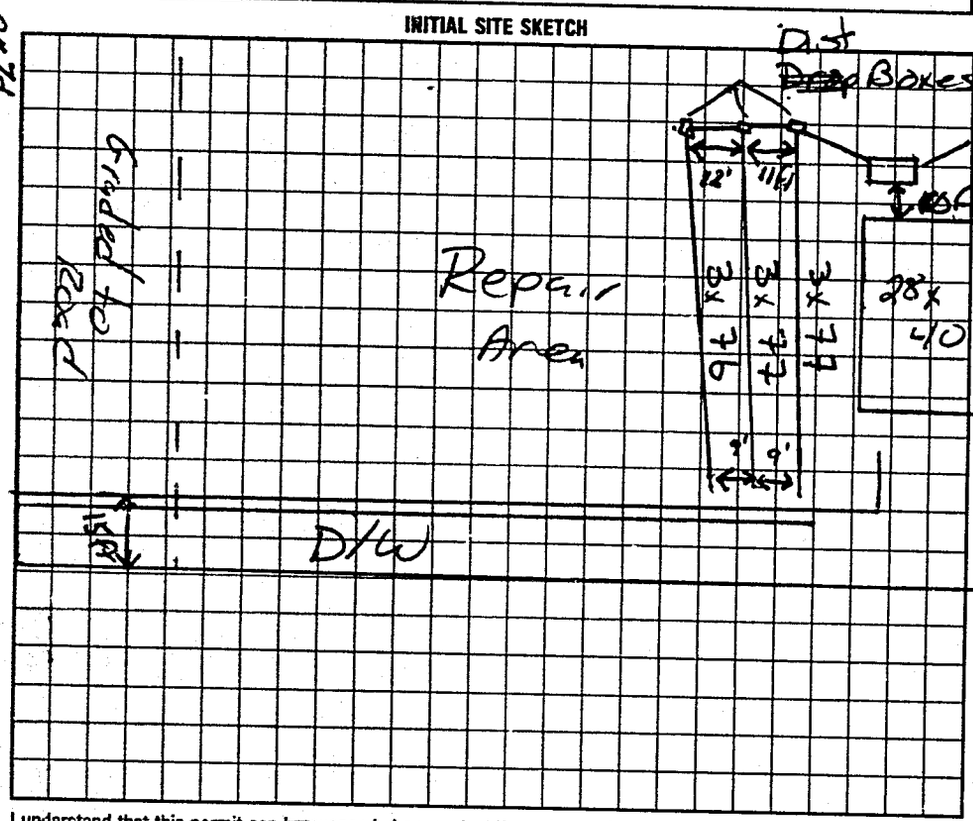

AS BUILT SKETCH

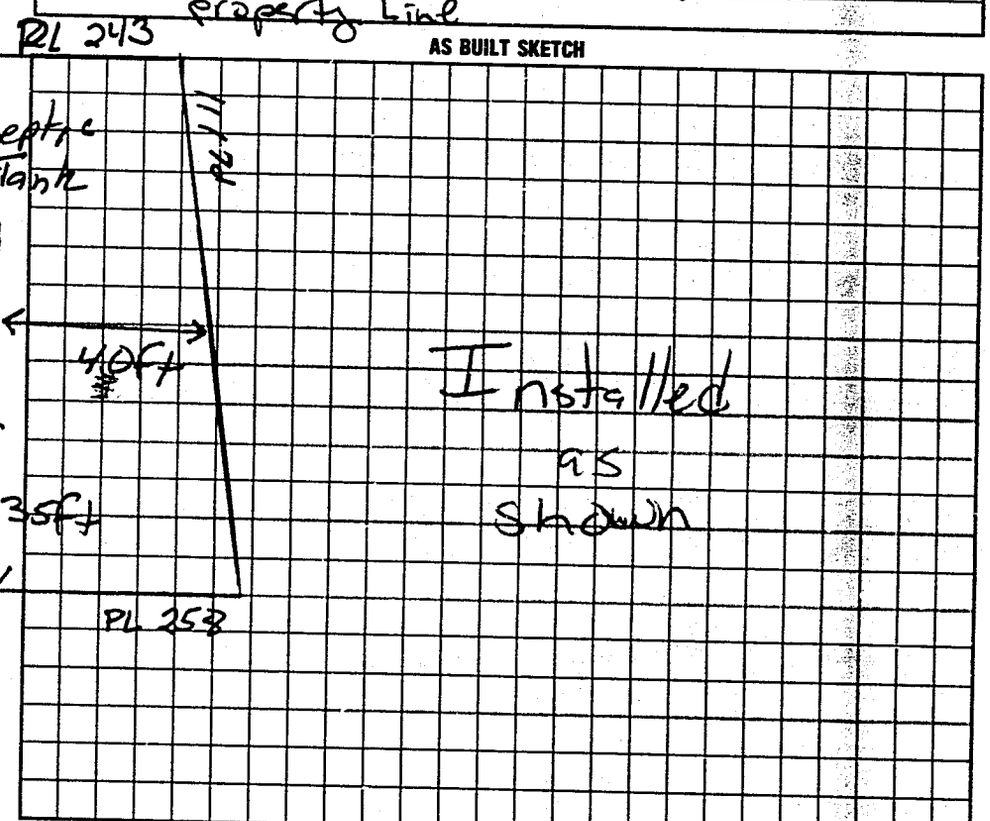

I understand that this permit can be suspended or revoked if any false information is supplied toward securing the permit/any unauthorized changes are made to the site/any unauthorized changes are made in the installation of the system. Improvement Permit is valid for 60 months from date of issuance. Authorization to construct expires 5 yrs from issued date.

Signed:

Improvement Permit by: Mark C Out RS date 9-6-97

~~Existing System Inspection by:~~ Authorization to const. Mark C Out RS date 9-6-97

Installed by: Chris Davidson

Certificate of Completion by: date

Operation Permit by: Mark C Out RS date 3-31-98

HEALTH DEPT. COPY: WHITE INSPECTION COPY (FINAL): GREEN OWNER COPY (FINAL): YELLOW INSPECTION COPY (INITIAL): PINK OWNER COPY (INITIAL): GOLD