IREDELL COUNTY HEALTH DEPARTMENT

STATESVILLE 704-878-5305 MOORESVILLE 704-664-5281

IMPROVEMENT PERMIT / CERTIFICATE OF COMPLETION / OPERATION PERMIT / EXISTING SYSTEM INSPECTION

PROPERTY DESCRIPTION NO. 069182 DATE 8-9-6-97 TAX MAP NO. 471/38542

OWNER OR CONTRACTOR Chris Davidson (D+D Enterprises) PHONE: Business 5786192 Home

ADDRESS POBox 5602 Statesville NC Watershed: ☒ Yes ☐ No WSIV PA

LOCATION Buffalo Shoals TR Clara Drive last lot on (R) at

SUBDIVISION Trotman Trace BLOCK / SECTION LOT 9 LOT AREA 21780 SITE CLASS. 4/5 DESIGN FLOW 240 L.T.A.R. 0.3

Septic Tank: 1000 Gallons; STB 1007 Date

Pump Tank: Gallons; PT Date

Pump Make: Model Serial No.

Nitrification Field: No Fields 1 Square Feet 800 Linear Feet 270

No Lines 4 Trench Width 36in Max Trench Bottom Depth 36in Gravel Depth 12in

☒ New System ☐ Repair System Type: I, ☒ II, III, IV, V, VI

System Description: Conventional Gravity

Repair System Description: Conventional Gravity Pump

Maintenance Agreement Required: ☐ Yes ☒ No

☒ House/Mod. Home ☐ Mobile Home ☐ Business ☐ Other

No. Bedrooms 2 No. Bathrooms 2 No. Employees


☐ Slab ☒ Crawl Space ☐ Basement w/plumbing ☐ Basement wo/plumbing

Water Supply: ☐ Individual ☒ Community ☐ Public well


Comments: keep Lines on contour keep water line 10ft from system.

Comments:

INITIAL SITE SKETCH

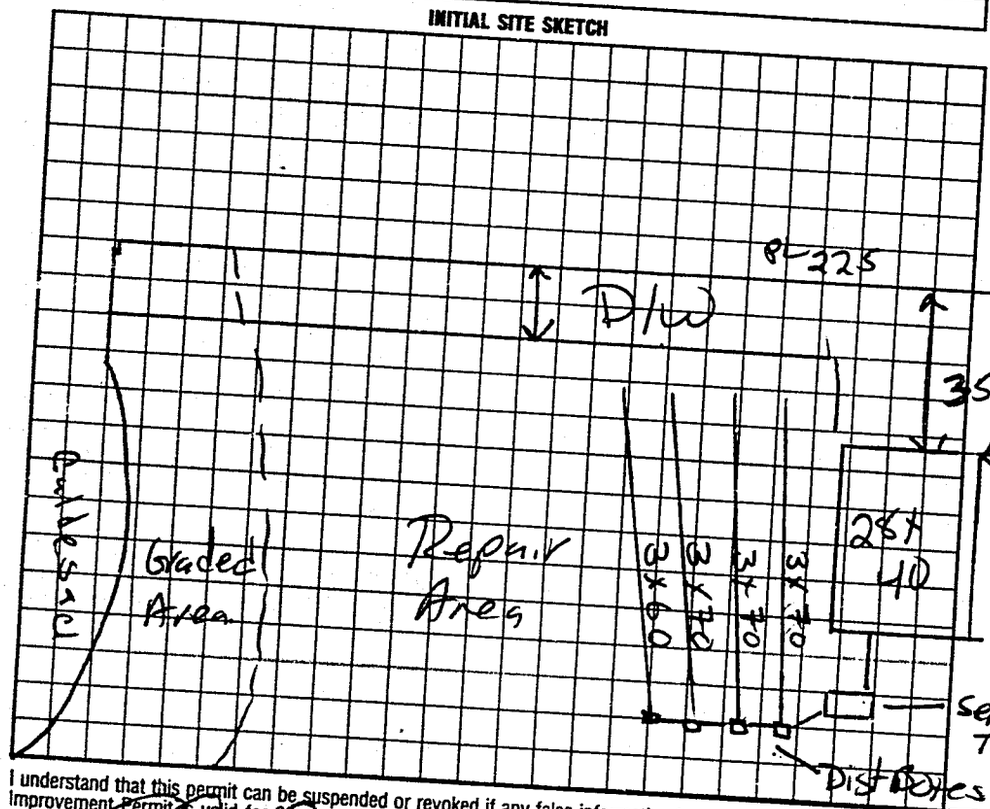

AS BUILT SKETCH

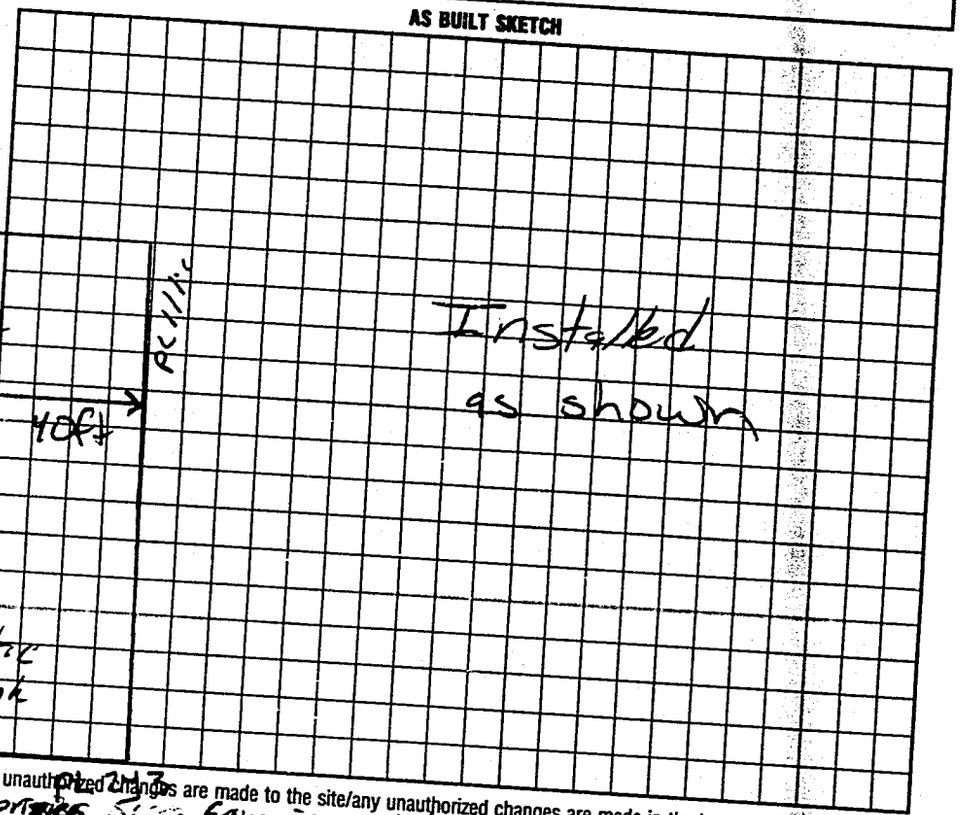

I understand that this permit can be suspended or revoked if any false information is supplied toward securing the permit/any unauthorized changes are made to the site/any unauthorized changes are made in the installation of the system. Improvement Permit is valid for 60 months from date of issuance. Authorization to construct expires 5 yrs from issue date.

Signed:

Improvement Permit by: Mark C Ort RS date 9-6-97

Existing System Inspection by: Mark C Ort RS date 9-6-97

Installed by: Charlie Brise

Certificate of Completion by: date

Operation Permit by: Mark C Ort RS date 5-12-98

HEALTH DEPT. COPY: WHITE INSPECTION COPY (FINAL): GREEN OWNER COPY (FINAL): YELLOW INSPECTION COPY (INITIAL): PINK OWNER COPY (INITIAL): GOLD