IREDELL COUNTY HEALTH DEPARTMENT

STATESVILLE 704-878-5305 MOORESVILLE 704-664-5281

IMPROVEMENT PERMIT / AUTHORIZATION TO CONSTRUCT / OPERATION PERMIT / EXISTING SYSTEM INSPECTION

PERMIT# 6918 PIN# 5286 192 000 DATE 1-7-98

OWNER OR CONTRACTOR Chris Davidson (D+D Enterprises) PHONE: Business 528 6192 Home

ADDRESS PO Box 5602 Statesville

LOCATION Bubbale Shoales TR Clara Drive 7th lot Rt.

SUBDIVISION Trentman Trace BLOCK / SECTION LOT 8 LOT AREA 29734 SITE CLASS. PS DESIGN FLOW 240 L.T.A.R. 3

Septic Tank: 1000 Gallons; STB 794 Date 12-3-98

Pump Tank: Gallons; PT Date

Pump Make: Model Serial No.

Nitrification Field: No Fields 1 Square Feet 810 Linear Feet 270

No Lines 3 Trench Width 36" Max Trench Bottom Depth 36" Gravel Depth 12"

☑ New System ☐ Repair System Type: I, II, III, IV, V, VI

System Description: Conv. Gravity

Repair System Description: Gravity Chambers

Maintenance Agreement Required: ☐ Yes ☑ No

☑ House/Mod. Home No. Bedrooms 3

☑ Mobile Home No. Bathrooms 2

☐ Business No. Employees

☐ Other


☐ Slab ☑ Crawl Space ☐ Basement w/plumbing ☐ Basement wo/plumbing

Water Supply: ☐ Individual ☐ Public ☑ Community


Comments:/Conditions:

Comments:/Conditions:

INITIAL SITE SKETCH

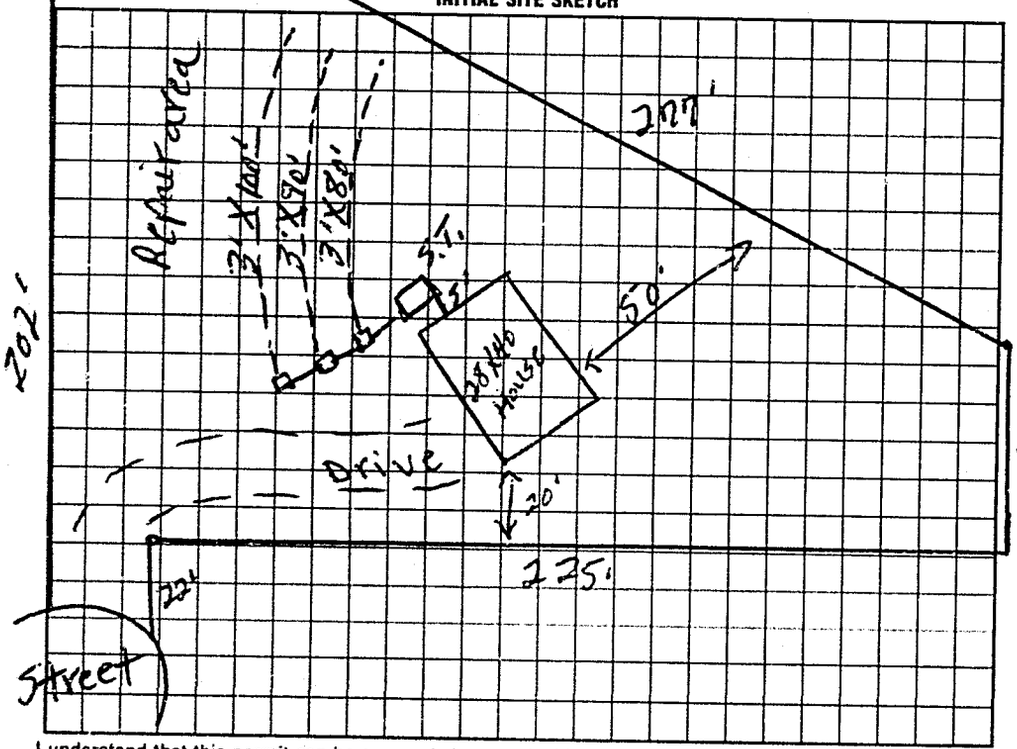

AS BUILT SKETCH

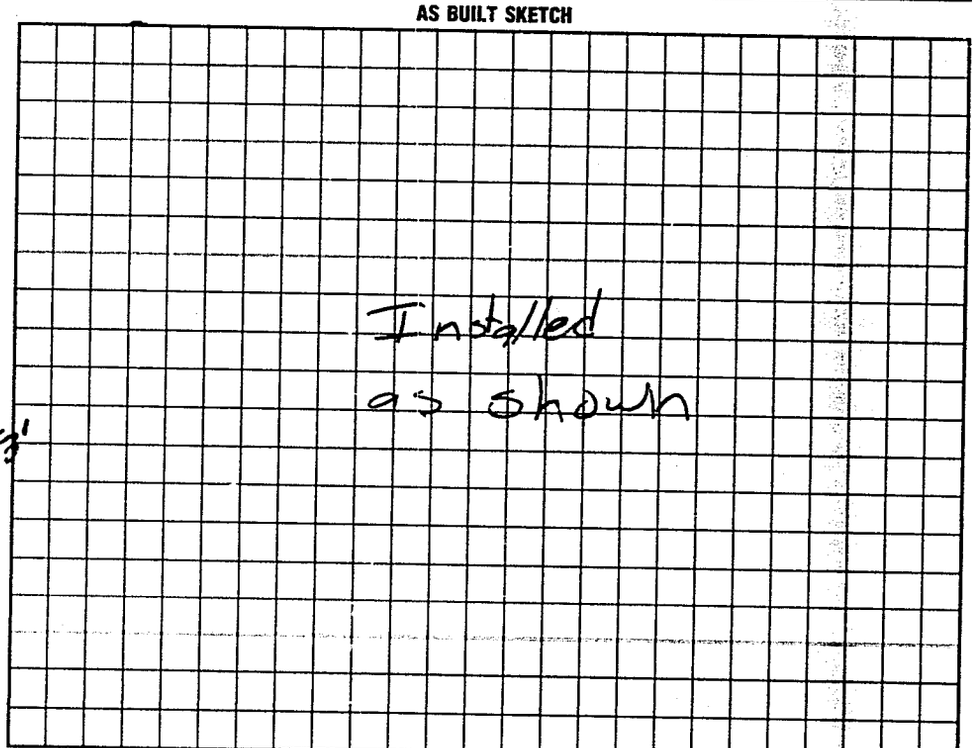

I understand that this permit can be suspended or revoked if any false information is supplied toward securing the permit/any unauthorized changes are made to the site/any unauthorized changes are made in the installation of the system. Improvement Permit with plat valid without expiration. Improvement Permit with site plan valid for sixty months. Authorization to Construct is valid for a period equal to that of Improvement Permit – not to exceed sixty months.

Signed: Neal Kale date

Improvement Permit by: E.C. Moore date 1-7-98

Authorization to Construct by: E.C. Moore date 1-7-98

Installed by: Charlie Brice

Operation Permit by: Neal Kale date 6-21-98

Existing System Inspection by: date

HEALTH DEPT COPY WHITE INSPECTION COPY (FINAL) GREEN OWNER COPY (FINAL) YELLOW INSPECTION COPY (INITIAL) PINK OWNER COPY (INITIAL) GOLD