IREDELL COUNTY HEALTH DEPARTMENT

STATESVILLE 704-878-5305 MOORESVILLE 704-664-5281

IMPROVEMENT PERMIT / CERTIFICATE OF COMPLETION / OPERATION PERMIT / EXISTING SYSTEM INSPECTION

PROPERTY DESCRIPTION NO. 18696 DATE 10-9-95 TAX MAP NO. 3Q-4 A-9 Watershed: ☐ Yes ☐ No

OWNER OR CONTRACTOR Olde Town mobile Homes PHONE: Business 873-1481 Home

ADDRESS 2016 N. Side Dr. Statesville

LOCATION Buffalo Shoals Rd TR Trautman Shoales 300' on Lft.

SUBDIVISION Trautman BLOCK / SECTION LOT 9 LOT AREA .68acres SITE CLASS. DESIGN FLOW L.T.A.R.

Septic Tank: 1000 Gallons, STB 794 Date 8-2-95

Pump Tank: Gallons; PT Date

Pump Make: Model Serial No.

Nitrification Field: No Fields 1 Square Feet 310 Linear Feet 270

No Lines 3 Trench Width 36" Max Trench Bottom Depth 36" Gravel Depth N/A

☑ New System ☐ Repair System Type: I, II, III, IV, V, VI

System Description: Chambered Graveless Gravity

Repair System Description: Pump To Panels PPBS

Maintenance Agreement Required: ☐ Yes ☐ No

☐ House/Mod. Home ☐ Mobile Home ☐ Business ☐ Other

No. Bedrooms 3 No. Bathrooms 2 No. Employees


☐ Slab ☑ Crawl Space ☐ Basement w/plumbing ☐ Basement wo/plumbing

Water Supply: ☐ Individual ☐ Community ☐ Public


Comments: Equiv. 36" conventional

Comments:

INITIAL SITE SKETCH

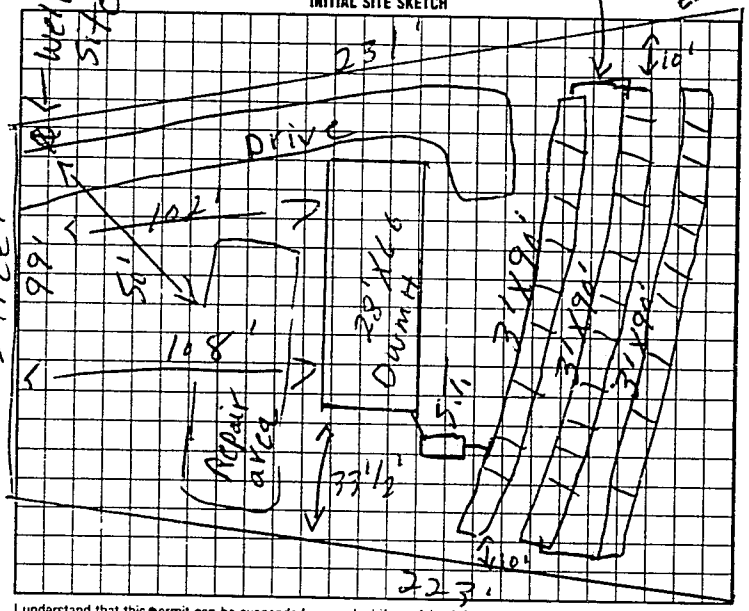

AS BUILT SKETCH

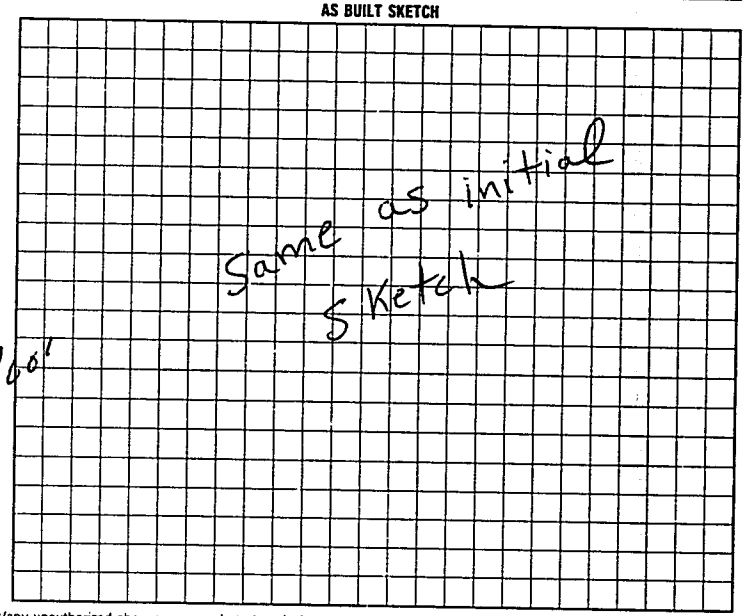

I understand that this permit can be suspended or revoked if any false information is supplied toward securing the permit/any unauthorized changes are made to the site/any unauthorized changes are made in the installation of the system.

Signed:

Improvement Permit by: R.C. Moore date 10-9-95

~~Existing System Inspection by:~~ R.C. Moore date 10-9-95

Installed by: A-1 Backhoe

Certificate of Completion by: ~~R.C. Moore 10-24-95~~

Operation Permit by: R.C. Moore date 10-24-95

Authorization To Const.

WHITE COPY: INSPECTION COPY (FINAL): GREEN OWNER COPY (FINAL): YELLOW INSPECTION COPY (INITIAL): PINK OWNER COPY (INITIAL): GOLD

Authorization to const. Expires 60 mos. from date of issue

L6E100