IREDELL COUNTY HEALTH DEPARTMENT

STATESVILLE 704-878-5305 MOORESVILLE 704-664-5281

IMPROVEMENT PERMIT / AUTHORIZATION TO CONSTRUCT / OPERATION PERMIT / EXISTING SYSTEM INSPECTION

PERMIT# 93519 PIN# 4711 58 0543 PT DATE 1/9/01

OWNER OR CONTRACTOR Ronald Tadlock PHONE: Business _____ Home 528-0690

ADDRESS 154 Trantman Shoals Rd. Statesville NC 28677

LOCATION Buffalo Shoals, R Trantman Shoals, on R+

SUBDIVISION Tadlock Est BLOCK / SECTION _____ LOT 2 LOT AREA _____ SITE CLASS PS DESIGN FLOW 240 L.T.A.R. 0.3

Septic Tank: 1000 Gallons: STB 1012 Date 2/14/01
Pump Tank: _____ Gallons: PT _____ Date _____
Pump Make: _____ Model _____ Serial No. _____
Nitrification Field: No Fields 1 Square Feet 600 Linear Feet 200
No Lines 5@40' Trench Width 36" Max Trench Bottom Depth 36" Gravel Depth —

[X] New System [ ] Repair System Type: I, II, (III), IV, V, VI
System Description: Gravity 25% Reduc
Repair System Description: Gravity Panel
Maintenance Agreement Required: [ ] Yes [X] No


[ ] House/Mod. Home No. Bedrooms 2
[X] Mobile Home No. Bathrooms 1
[ ] Business No. Employees _____
[ ] Other _____
[ ] Slab [X] Crawl Space [ ] Basement w/plumbing [ ] Basement wo/plumbing

Water Supply: [X] Individual [ ] Public [ ] Community


Comments/Conditions:

Comments/Conditions: @ PUMP SEPTIC TANK EVERY 3-5 YRS

INITIAL SITE SKETCH

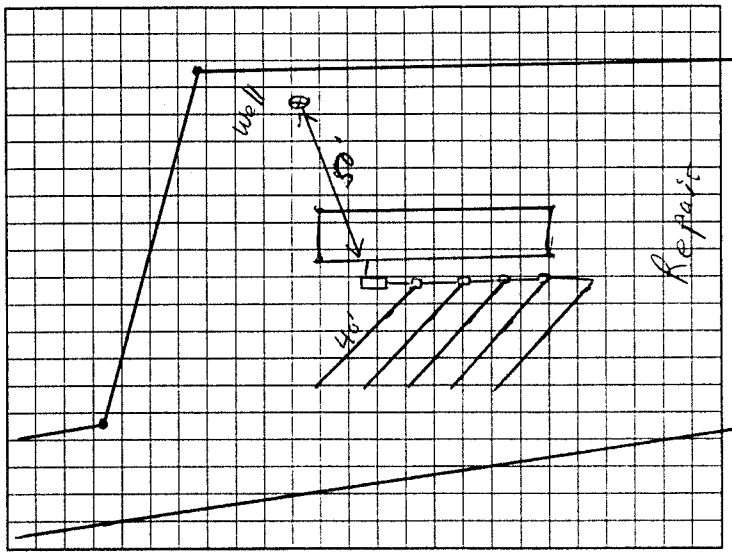

AS BUILT SKETCH

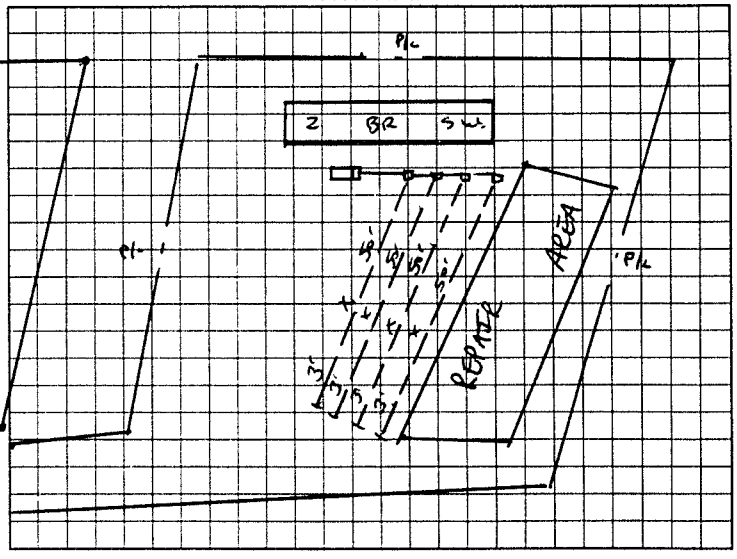

Permit can be suspended or revoked if any false information is supplied toward securing the permit/any unauthorized changes are made to the site/any unauthorized changes are made in the installation of the system. Improvement Permit with plat valid without expiration. Improvement Permit with site plan valid for sixty months. Authorization to Construct is valid for a period equal to that of Improvement Permit – not to exceed sixty months.

Signed: Ronald Lee Tadlock date 1/11/01 Installed by: A-1 BACKHOE

Improvement Permit by: RST date 1/9/01 Operation Permit by: _____ date 4/10/01

Authorization to Construct by: RST date 1/9/01 Existing System Inspection by: _____ date _____

HEALTH DEPT. COPY WHITE OWNER COPY (FINAL) YELLOW OWNER COPY (INITIAL) PINK